

- 10 CONTRACTOR SHALL REMOVE ALL TRASH AND DEBRIS DAILY. DEMOLITION WORK SHALL REMAIN SAFE & CLEAN FOR THE BUILDING'S OCCUPANTS & CONSTRUCTION WORKERS. OCCUPIED AREAS ADJACENT TO THE PROJECT WORK AREAS SHALL BE KEPT CLEAN AT ALL TIMES DURING THE WORK.
- PARTIALLY DEMOLISHED. THE TEMPORARY WORK SHALL KEEP THE PARTIALLY DEMOLISHED WORK STABILIZED. WHERE EXISTING CONSTRUCTION IS SHOWN TO BE PARTIALLY DEMOLISHED, EXTEND

	SHEET KEYNOTES
0201	REMOVE EXISTING CIRCADIAN BOX BY NEIU
0202	REMOVE EXISTING FAUCET
0203	EXISTING FLOOR DRAIN TO REMAIN
0204	REMOVE RAISED FLOOR PLATFORM. SCAN THE PLATFORM FOR PIPES AND CONDUITS BEFORE DEMOLITION
0205	REMOVE EXISTING SINK - SEE PLUMBING DRAWINGS.
0206	REMOVE EXISTING LAB DRYING BOARD
0207	REMOVE AND SALVAGE EXISTING STORAGE UNIT BY NEIU
0208	SAWCUT AND REMOVE EXISTING STRUCTURAL GLAZED FACING TILE WALL FOR NEW DOOR OPENING.
0209	REMOVE AND RE-INSTALL EXISTING MOBILE METAL TABLE BY NEIU
0210	REMOVE AND RELOCATE EXISTING 6' X 2' METAL RACK BY NEIU
0211	REMOVE AND SALVAGE EXISTING COMPUTER BOX BY NEIU
0212	EXISTING GREEN HOUSE ENCLOSURE. TO REMAIN.
0213	REMOVE AND SALVAGE EXISTING TABLE BY NEIU
0214	REMOVE, SALVAGE AND REINSTALL EXISTING WALL-MOUNTED EYEWASH
0215	REMOVE AND RE-INSTALL EXISTING CABINET BY NEIU
0216	REMOVE EXISTING RACK BY NEIU
0217	REMOVE AND RE-INSTALL EXISTING FISH TANK & RACK BY NEIU
0218	REMOVE AND RE-INSTALL EXISTING FRIDGE BY NEIU
0219	REMOVE PORTION OF WALL FOR NEW DUCT WORK. SEE MECHANICAL DRAWINGS.
0220	CUT ROOF TO ACCOMODATE NEW ROOF THROUGH PLUMBING VENT, SEE PLUMBING.
0221	SAW CUT STRUCTURAL GLAZED FACING TILE WALL, TO ACCOMODATE COLD WATER FEEDER FC FISH TANKS, SEE PLUMBING.
0222	REMOVE EXISTING FINISH CEILING, CEILING SOFFITS, CEILING DEVICES AND FIXTURES
0224	REMOVE EXISTING CASEWORK. REMOVE AND SALVAGE EXISTING STAINLESS STEEL COUNTERTOP FOR NEW WORK.
0225	REMOVE AND RE-INSTALL EXISTING FARADAY BOX BY NEIU
0226	REMOVE AND RE-INSTALL EXISTING TABLE BY NEIU
0227	REMOVE AND RE-INSTALL EXISTING TOOLBOX BY NEIU
0228	REMOVE AND RE-INSTALL EXISTING CRYO BY NEIU
0229	REMOVE AND RE-INSTALL EXISTING COMPUTER BY NEIU
0230	EXISTING GREEN HOUSE
0231	REMOVE COVER ONLY OF EXISTING ROOF HATCH. HATCH FRAME OPENING AND CAP FLASHING TO REMAIN.
0233	EXISTING VENTS TO REMAIN
0234	REMOVE EXISTING ROOF EXHAUST, SEE MECHANICAL
0235	REMOVE EXISTING WALL-MOUNTED HW, CW, A & S TO MAIN AND CAP, SEE PLUMBING DRAWING
0242	EXISTING ROOF TO REMAIN, TYPICAL
0243	REMOVE EXISTING DOOR, EXISTING FRAME TO REMAIN
0244	REMOVE EXISTING FLOOR FINISH AND PREP IT TO TAKE NEW FLOOR FINISH, TYPICAL.
0245	TEMPORARILY REMOVE AND SALVAGE EXISTING CEILING GRID AND TILES TO ACCOMODATE MECHANICAL WORK. INSTALL NEW MECHANICAL WORK. PROTECT EXISTING FIXTURES, FINISHE EQUIPMENT, FURNISHING DURING REMOVAL. RE-INSTALL EXISTING CEILING TILES. PATCH, CLEA

AND REPAIR ANY DAMAGE TO THE EXISTING SPACE. SEE MECHANICAL DRAWINGS. 0246 REMOVE EXISTING WALL MOUNTED FIXTURES, EXISTING WIREMOLD AND EXISTING OUTLETS, TYPICAL - SEE ELECTRICAL, AND MECHANICAL DRAWINGS.




- EXISTING LIGHT FIXTURE TO BE REMOVED; REF. TO ELECTRICAL PLANS
- EXISTING MECH. SUPPLY DIFFUSER TO BE REMOVED; REF. MECHANICAL PLANS
- EXISTING MECH. RETURN DIFFUSER TO BE REMOVED; REF. MECHANICAL PLANS
- - INDICATES EXTENT OF DEMOLITION WORK
 REQUIRED BY KEYNOTE THROUGHOUT ROOM
 OR SPACE
 - EXISTING HEAT DETECTOR TO BE REMOVED.

AREA OUTSIDE THE EXTENT OF INTERIOR FINISH WORK

DEMOLITION PLAN LEGEND


- EXISTING WALL TO BE DEMOLISHED
- EXISTING WALL TO REMAIN
- EXISTING DOOR AND FRAME TO REMAIN
- EXISTING DOOR AND FRAME TO BE DEMOLISHED
 - EXISTING TO BE DEMOLISHED
 - INDICATES EXTENT OF DEMOLITION WORK REQUIRED BY KEYNOTE THROUGHOUT ROOM OR SPACE
 - AREA OUTSIDE THE EXTENT OF INTERIOR FINISH WORK



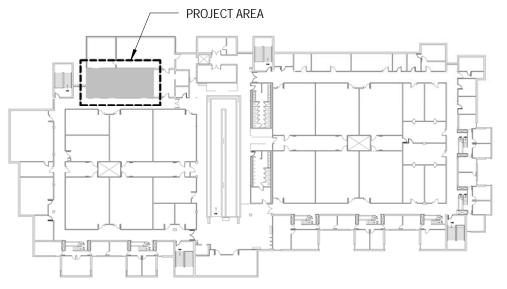


bailey edward
t 312.440.2300 f 312.440.2303 www.baileyedward.com
35 East Wacker Dr Suite 2800 Chicago, IL
60601-2308 ©2013 Bailey Edward Design
Design Firm License No. 184-001962
Image: Solution of the sector of the sect
PROJECT NOTES
Revision Schedule No. Date Description 1 4/24/2013 ISSUED FOR BID
2 5/2/2013 ISSUED AS ADDENDUM #1
SITE PLAN
BERNARD J. BROMMEL HALL (PROJECT BUILDING)
Northeastern Illinois 5500 NORTH ST. LOUIS AVENUE CHIAGO, IL 60625
University TELEPHONE: 773/442-5230 FASCIMILE: 773/442-5280
PROJECT VIVARIUM & MARINE ORGANISMS RENOVATION
NEIU # 11-0333-0213 BE # 1302-13-01 BUILDING ID/NAME: BERNARD J. BROMMEL HALL
ARCHITECTURAL DEMOLITION PLANS
DATE 4/24/2013 SCALE As indicated
PG SHEET No.

MP

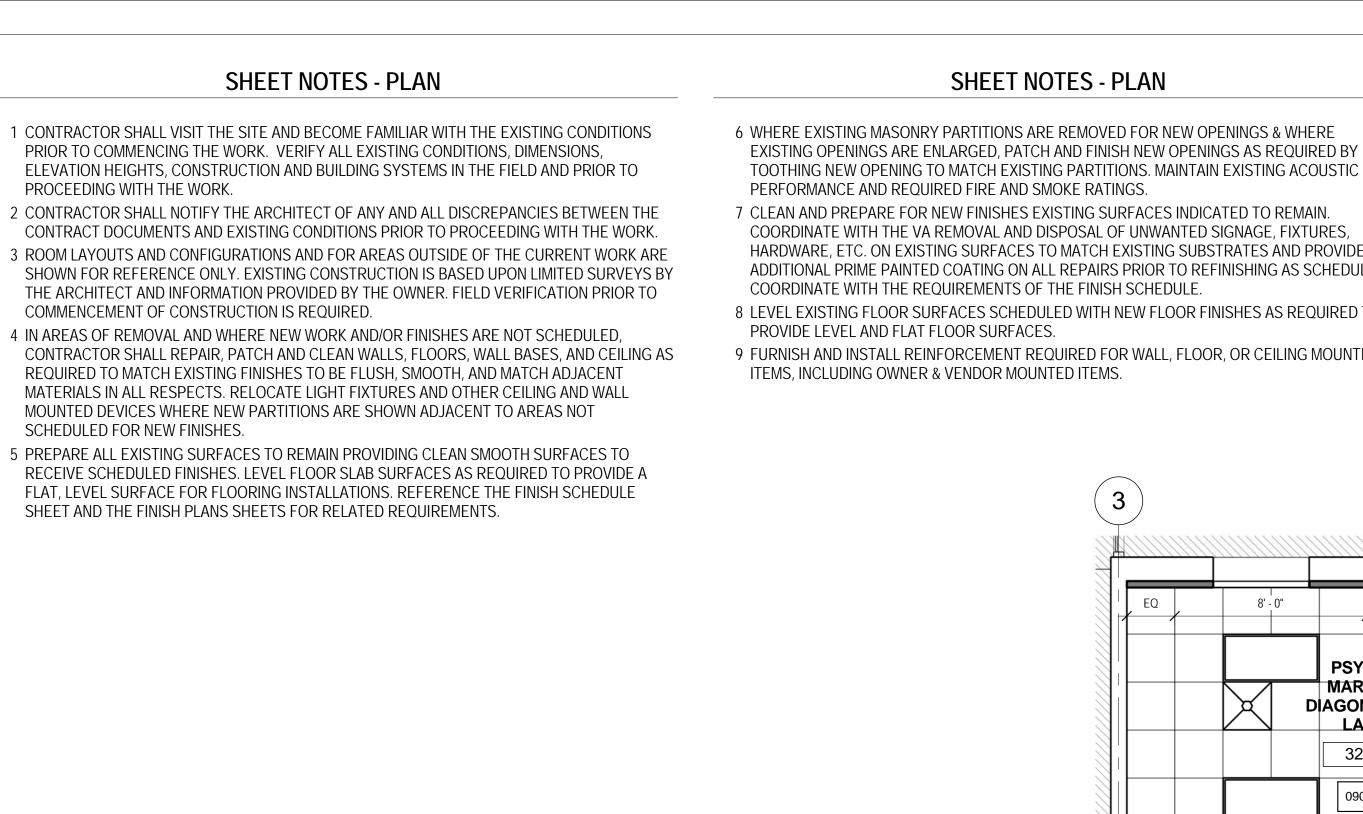




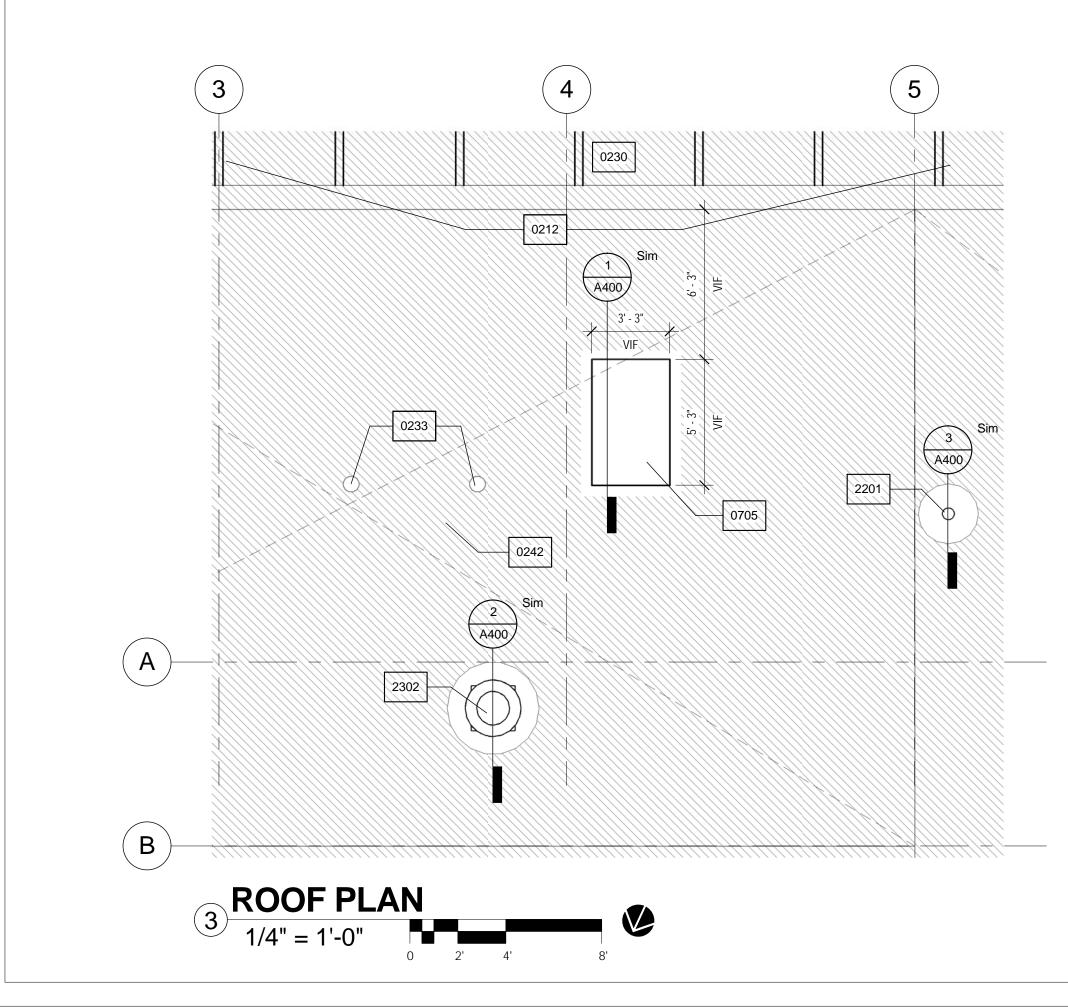


SHEET NOTES - PLAN

- 6 WHERE EXISTING MASONRY PARTITIONS ARE REMOVED FOR NEW OPENINGS & WHERE EXISTING OPENINGS ARE ENLARGED, PATCH AND FINISH NEW OPENINGS AS REQUIRED BY
- 7 CLEAN AND PREPARE FOR NEW FINISHES EXISTING SURFACES INDICATED TO REMAIN.
- COORDINATE WITH THE VA REMOVAL AND DISPOSAL OF UNWANTED SIGNAGE, FIXTURES, HARDWARE, ETC. ON EXISTING SURFACES TO MATCH EXISTING SUBSTRATES AND PROVIDE AN ADDITIONAL PRIME PAINTED COATING ON ALL REPAIRS PRIOR TO REFINISHING AS SCHEDULED.
- 8 LEVEL EXISTING FLOOR SURFACES SCHEDULED WITH NEW FLOOR FINISHES AS REQUIRED TO
- 9 FURNISH AND INSTALL REINFORCEMENT REQUIRED FOR WALL, FLOOR, OR CEILING MOUNTED

- **SHEET NOTES PLAN**
- 10 ALL PENETRATIONS OF FLOORS AND FIRE RATED WALL OR SMOKE PARTITIONS SHALL BE PATCHED & REPAIRED AS REQUIRED TO MAINTAIN THE EXISTING FIRE RATING OR SMOKE INFILTRATION INTEGRITY OF THE FLOOR AND WALL ALL SLEEVES, WIREWAYS, CABLE TRAYS, PIPES, DUCTWORK, ARE TO BE FIRE SEALED TIGHT TO THE WALL OR FLOOR PENETRATIONS TO MAINTAIN THE REQUIRED CODE COMPLIANT FIRE RATING.
- 11 DO NOT APPLY NEW FINISHES TO EXISTING WALL AND CEILING MOUNTED DEVICES, FIXTURES, COVER PLATES, SIGNAGE, HARDWARE, ITEMS, ETC, LOCATED ON EXISTING SURFACES SCHEDULED TO BE REFINISHED. EXISTING ITEMS THAT ARE NOT REMOVABLE SHALL BE CAREFULLY TAPED, OR OTHERWISE COVERED DURING REFINISHING. WHERE NEW FINISHES ARE APPLIED EXISTING FINISHES NO LONGER VISIBLE SURROUNDING EXISTING ITEMS.
- 12 PROVIDE HEAVY GAUGE METAL STRAPPING OR FIRE RATED BLOCKING WITHIN THE WALL CAVITY FOR ALL WALL MOUNTED EQUIPMENT, GRAB BARS, AND CABINETS.
- 13 INSTALL SEALANT AND BACKER ROD AT ALL HORIZONTAL EDGES WHERE NEW AND/OR EXISTING WALLS MEET THE STRUCTURE ABOVE. ALSO ADD SEALANT AND BACKER ROD TO VERTICAL EDGES WHERE NEW AND/OR EXISTING WALLS MEET AND AT EXISTING DOOR LINTELS.
- 14 PATCH AND REPAIR EXISTING WALLS. THE TOTAL AMOUNT OF PATCHING IS ASSUMED TO BE APPROXIMATELY 21 LINEAL FEET.

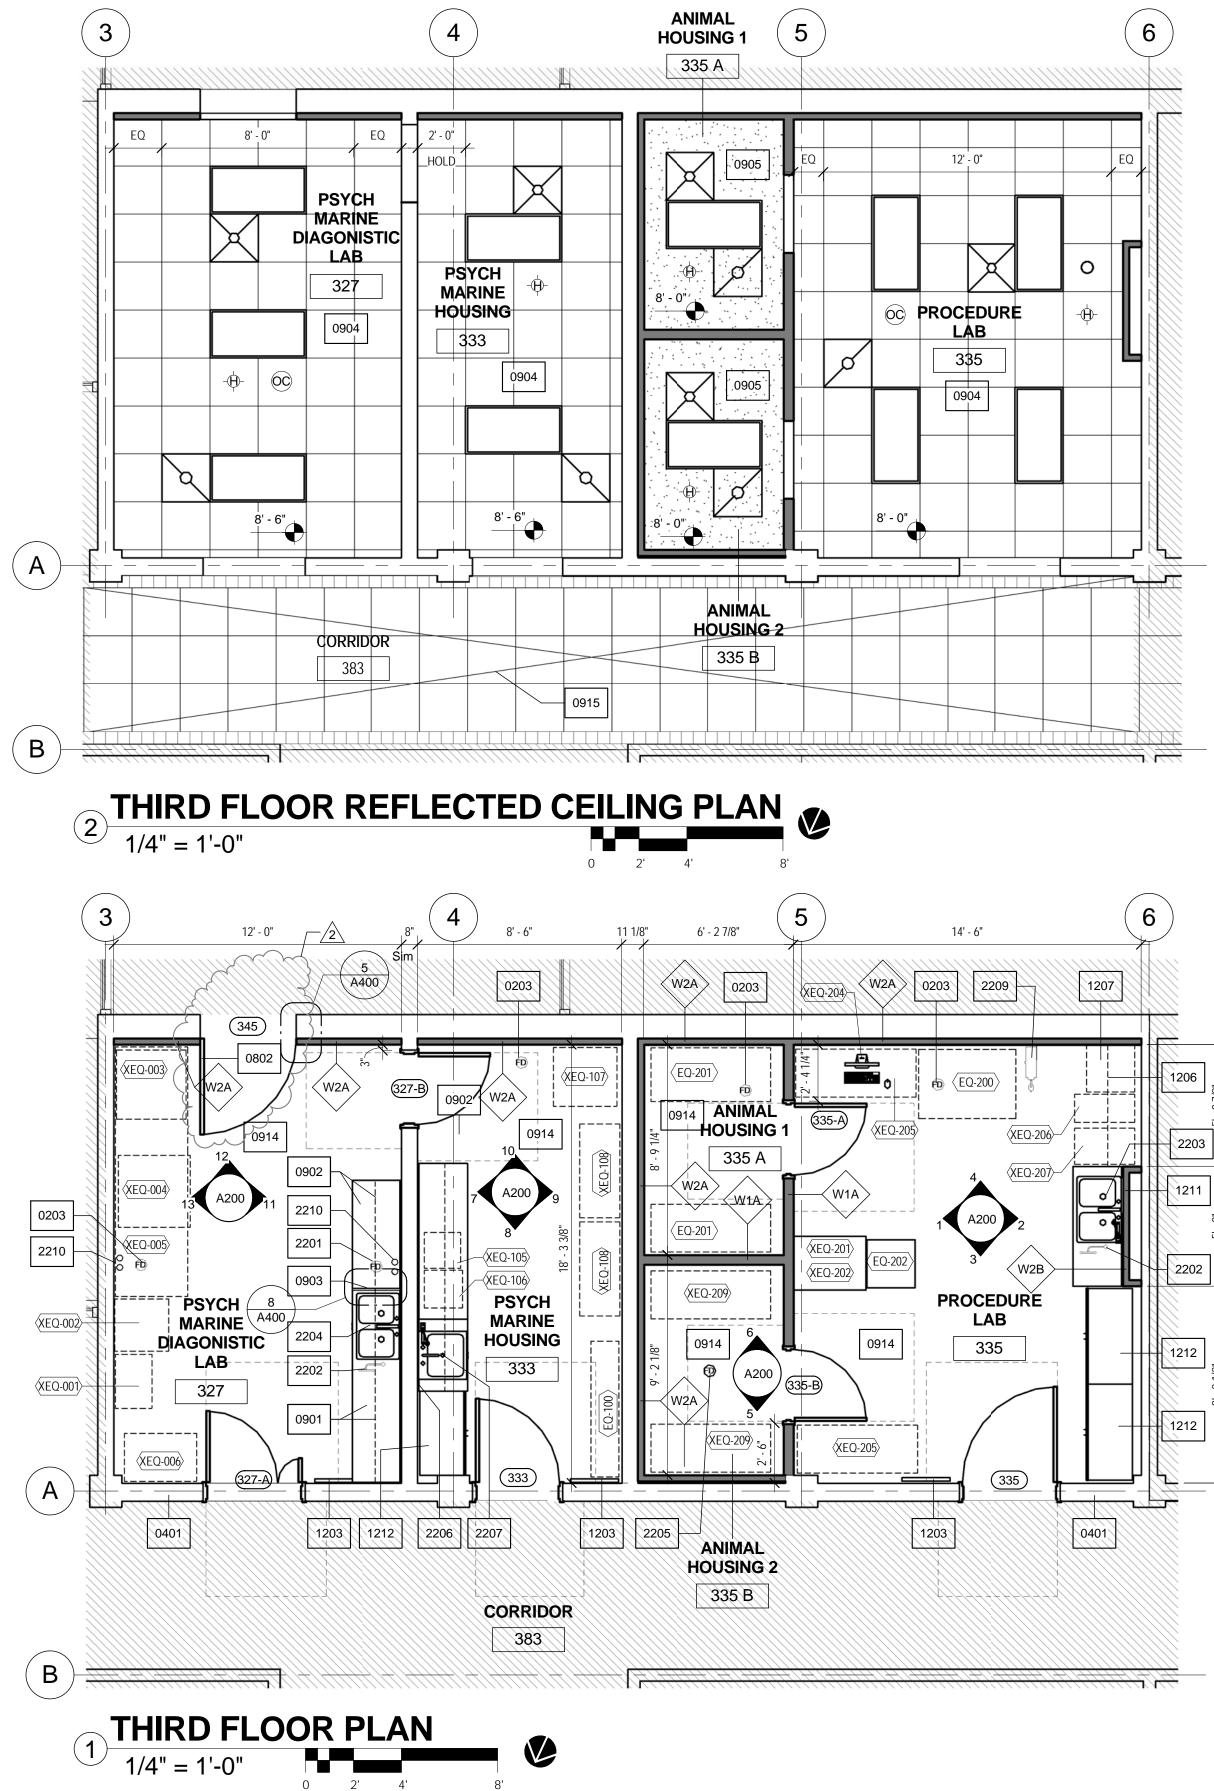

		SHEET KEYNOTES
	0203	EXISTING FLOOR DRAIN TO REMAIN
	0212	EXISTING GREEN HOUSE ENCLOSURE. TO REMAIN.
	0230	EXISTING GREEN HOUSE
	0233	EXISTING VENTS TO REMAIN
\land —	0242	EXISTING ROOF TO REMAIN, TYPICAL
	0401	PATCH AND SEAL WALL AT AREA OF MECH DUCT REMOVAL. MAINTAIN THE ASSUMED 1-HR FIRE RATING OF WALL. VIF.
2	0705	NEW INSULATED ROOF HATCH COVER.
ζ'	0802	NEW INSULATED FIBERGLASS DOOR, SEE DOOR SCHEDULE
7	0901	NEW LAB CASEWORK, UPPER AND BASE CABINET
	0902	NEW LAB CASEWORK, UPPER AND BASE CABINET. NEW SOLID SURFACE COUNTERTOP
	0903	SOLID SURFACE SPLASH GUARD.
	0904	NEW ACOUSTIC CEILING TILE
	0905	NEW DRYWALL CEILING
	0914	SCHEDULED FLOOR FINISH
	0915	REINSTALL EXISTING CEILING SYSTEM AND CEILING MOUNTED DEVICES. REFER TO SHEET D100.
	1203	2' H X 1'-6" W TACK BOARD
	1206	UPPER STORAGE CABINET WITH ADJUSTABLE SHELVES
	1207	EXISTING GARBAGE CONTAINER
	1211	WALL-HUNG GLASSWARE PEGBOARDS, 18"X24" MODEL NO. 52L80500.
	1212	FULL-HEIGHT LAB CASEWORK CABINETS
	2201	NEW PLUMBING VENT THROUGH ROOF, SEE PLUMBING.
	2202	EYE WASH, COUNTER TOP MOUNTED. SEE PLUMBING.
	2203	SINK WITH IR SENSOR AND MANUAL SPRAYER, SEE PLUMBING.
	2204	RE-INSTALL EXISTING STAINLESS STEEL COUNTERTOP AND INTEGRAL SINK. INSTALL NEW FAUCETS AND FOOT PEDAL CONTROL. SEE PLUMBING.
	2205	NEW FLOOR DRAIN, SEE PLUMBING DRAWING.
	2206	RECONNECT AND RE-INSTALL EXISTING WALL-MOUNTED EYEWASH, SEE PLUMBING.
	2207	SINK WITH FOOT PEDAL CONTROL AND MANUAL SPRAYER, SEE PLUMBING DRAWING.
	2209	WALL MOUNTED WASH-DOWN HOSE, SEE PLUMBING.
	2210	PATCH AND FILL EXISTING PLUMBING PIPES. CUT CONCRETE. VERIFY NOT IN OPERATION AND PLUG PIPING.
	2302	NEW ROOF EXHAUST OVER PRE MANUFACTURED CURB, SEE MECHANICAL SPEC AND DRAWING.

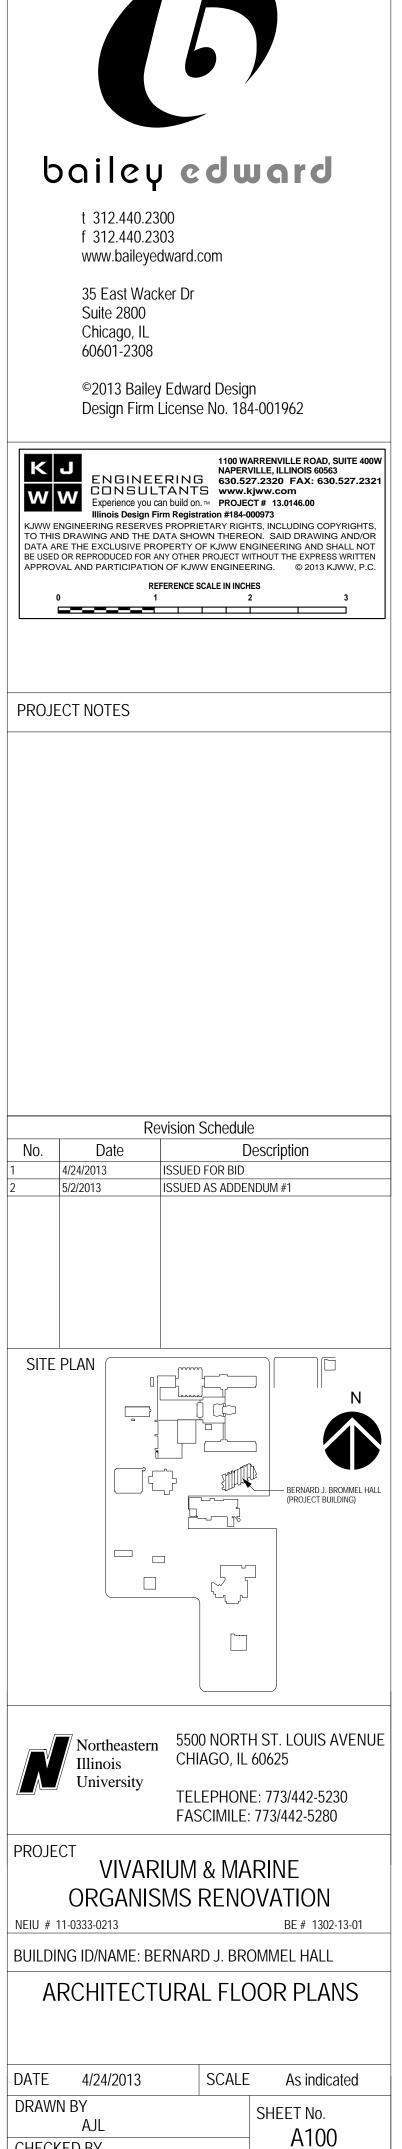

REFLECTED CEILING PLAN LEGEND

2x4 LIGHT FIXTURE

- \mathbf{X} MECH. SUPPLY DIFFUSER
- MECH. RETURN DIFFUSER
- RECESSED CAN LIGHT FIXTURE HEAT DETECTOR
- OC OCCUPANCY SENSOR
- GYPSUM BOARD CEILING
- 2X2 ACOUSTICAL CEILING TILE
- EXISTING CEILING TILE TO REMAIN

FLOOR PLAN LEGEND





EXISTING WALL TO REMAIN NEW WALL

- EXISTING DOOR AND FRAME TO REMAIN

NEW DOOR AND FRAME

KEY PLAN - THIRD FLOOR

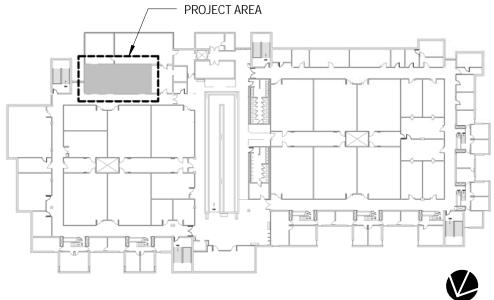

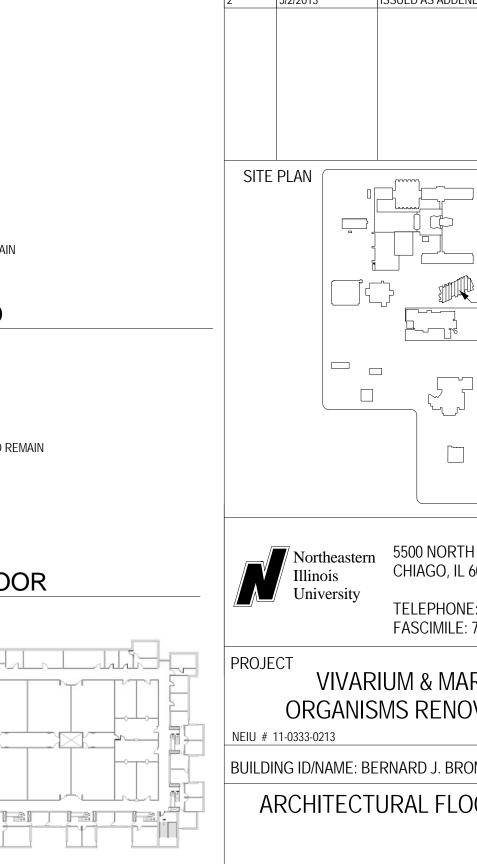

CHECKED BY

ME


6 of 23 SHEETS

				H SCHEDULE		FLOOR	BASE		DOOR SCHEDULE
ROOM NUMB	ER ROOM NAME	CEILING FINISH NO	RTH SOUTH		WEST	FINISH		COMMENTS	NUMBER NUMBER
7	PSYCH MARINE DIAGONISTIC	ACT-1 EXISTI	ING PT-2	PT-1	EXISTING	EPX-1	CB-1	EXISTING COLUMNS - PT1	중 Kennel
2	LAB PSYCH MARINE HOUSING	ACT-1 EXISTI	ING PT-2	EXISTING	EXISTING	EPX-1	CB-1	EXISTING COLUMNS - PT1	Product ROOM NAME Product WIDTH HEIGHT S TYPE AL FINISH TYPE M
33 35	PROCEDURE LAB	ACT-1 EXISTI		PT-1	EXISTING	EPX-1	CB-1	EXISTING COLUMNS - PT1	327 PSYCH MARINE DIAGONISTIC LAB 327-A 4'-0" 7'-0" 1 3/4" AA WD MATCH EXISTING T EX
35 A 35 B	ANIMAL HOUSING 1 ANIMAL HOUSING 2	GWB, PT-1 PT-2 GWB, PT-1 PT-2	PT-2 PT-2	PT-2 PT-2	PT-2 PT-2	EPX-1 EPX-1	CB-1 CB-1		327 PSYCH MARINE DIAGONISTIC LAB 327-B 3' - 0" Y 7' - 10" 1 3/4" Y A WD MATCH EXISTING 2 HN 327 PSYCH MARINE DIAGONISTIC LAB 345 4' - 0" 7' - 0" 2" A FRP MANUF. EXISTING EXISTING <td< td=""></td<>
00 D		GWD, PT-T PT-Z	F1-Z	F1-Z	P1-2				STANDARD A A A A A STANDARD A
									33395YCH MARINE HOUSING3333' - 6"7' - 10"1-3/4"AWDMATCH EXISTINGEXISTINGEXISTINGEXISTINGEXISTINGEXISTING33597000000000000000000000000000000000000
									335 PROCEDURE LAB 335 4 - 0 7 - 10 1 3/4 A WD MATCH EXISTING EXISTING EXISTING 335 A ANIMAL HOUSING 1 335-A 3' - 0" 7' - 10" 1 3/4" A WD MATCH EXISTING EXISTING EXISTING EXISTING EXISTING EXISTING
			ROOM FINI	SH LEGEND					335 B ANIMAL HOUSING 2 335-B 3' - 0" 7' - 10" 1 3/4" A WD MATCH EXISTING 1 HM
MATERIAL TYPE / CODE	MATERIAL DESCRIPTION	MATERIA MANUFACTU			ACTURER MODE			MATERIAL REMARKS	
	WATERIAL DESCRIPTION			WANUT /					SEE SCHEDULE 3'-0" 1'-0" 2" SEE SCHEDULE 2" 2
ACT-1	ACOUSTICAL CEILING TILE	SEE SPEC 095113	3 2x2, WI	HITE				CLEAN ROOM TILE, SCRUBABLE	
	INTEGRAL COVE BASE	SEE SPEC 096700		HENGE(ROCKTR					
	EPOXY FLOOR FINISH EPOXY PAINTMAIN FIELD WALL COI	SEE SPEC 096700	7	HENGE(ROCKTR WHITE (SHERWIN			1	LOW VOC	
PT-2	EPOXY PAOINT ACCENT WALL COL		(BRINDLE (SHERW				LOW VOC	
	EPOXY PAINT - DOOR FRAME COLOF METAL CASEWORK COLOR			NADE GRAY (SHE			· /	LOW VOC	
	SOLID SURFACE COUNTER	SEE SPEC 123553 SEE SPEC 123553		E ICE (FORMICA B					
		I							
			CASEWIORK	SCHEDULE					
TYPE	MODEL	DESCRIPTION	WIDT		H HEIG	HT COL	INT	FINISH COMMENTS	
BC-1	115J6320 Flush Overlay Steel B	ase Cabinet	3' - 0"	1' - 9 1/8"	2' - 11 1/	<u>/</u> " 2	PT-4	FOOT PADEL	- + + + + + + + +
								CONTROL	DOOR TYPE: ADOOR TYPE: AAFRAME TYPE: 1FRAMEKNOC
BC-2 BC-3	029J832LFlush Overlay Steel B106J632LFlush Overlay Steel B		5' - 0" 3' - 0"	1' - 9 1/8" 1' - 9 1/8"	2' - 11 1/ 2' - 11 1/		PT-4 PT-4	LOCK LOCK	
BC-4	303J432LFlush Overlay Steel B		2' - 0"	1' - 9 1/8"	2' - 11 1/		PT-4	LOCK	B DOOR & FRAME TYPES
BC-5 BC-6	306J8320Flush Overlay Steel B341J432LFlush Overlay Steel B		4' - 0" 2' - 0"	1' - 9 1/8" 1' - 9 1/8"	2' - 11 1/ 2' - 11 1/		PT-4 PT-4	LOCK	1/2" = 1'-0"
	525J3680 Flush Overlay Steel E		7/8"	2' - 4 7/8"	2' - 11 1/		PT-4		VARIES, VIF (7 5/8" ASSUMED)
	806J792LFlush Overlay Steel T806J892LFlush Overlay Steel T		3' - 6" 4' - 0"	1' - 10" 1' - 10"	7' - 0 5/8 7' - 0 5/8		PT-4 PT-4	LOCK LOCK	A SAW CUT THE BRICK TO
	, , , , , , , , , , , , , , , , , , , ,	neespace Panel and Rails		1' - 9 1/8"	2' - 11 1/		PT-4 PT-4		ACCOMMODATE METAL ANGLE FLANGES. 1/2"
	Kneespace522J3610Leg Assembly			1' - 9 5/8"	2' - 11 1/	/" 1	PT-4		
	52L80500 Glassware Pegboard		1' - 6"	1"	2 - 11 1/	4 1 1	PT-4		TILE WALL, SAW CUT OPENING TYP, DO NOT
	618J0340 Flush Overlay Steel F		1"	2"	2' - 11 1/		PT-4		OF THE DOOR.
WC-1 WC-2	702J423LFlush Overlay Steel V703J423LFlush Overlay Steel V		2' - 0" 2' - 0"	1' - 1" 1' - 1"	2' - 1 1/4 2' - 1 1/4		PT-4 PT-4	LOCK LOCK	SIDES TYP.
	706J523L Flush Overlay Steel V		2' - 6"	1' - 1"	2' - 1 1/4		PT-4		GROUT HEAD
WC-4 WC-5	706J623LFlush Overlay Steel V706J823LFlush Overlay Steel V		3' - 0" 4' - 0"	1' - 1" 1' - 1"	2' - 1 1/4 2' - 1 1/4		PT-4 PT-4	LOCK LOCK	HM FRAME SCHEDULED DOOR
	OF DESIGN: THERMO FISHER SCIENT		NI 102552						
	OF DESIGN. THERMOTISTER SCIENT	inte, del di le dechoi	123333						WELD 5/16" THICK METAL PLATE TO THE ANGLE
		EQUIPMENT SCH	EDULE SEE ALS	O SPECIFICATION	SECTION 11 00	00			
	DESCRIPTION	MANUFACTU						COMMENTS	20 GA DOUBLE MET
NUMBER	DESCRIPTION	IVIAINUFACTUI			2 PROVIDED E	51		COMMENTS	5 DOOR HEAD DETAIL - EXISTING WALL
EQ-100	Fish tank system (Z-Hib Mini)	Aquatic Habitat, Ber	· ·			•	er). Future in		3'' = 1'-0'' $3'' = 1'-0''$ $3'' = 1'-0''$ $3'' = 1'-0''$ $5 = 1'-0$
EQ-200 EQ-201	Bedding station Animal cage racks	Techiplast, DS36 TBD	335 335	115V - 8.6 A NA	CFCI OFCI	Exhaust a Quantity 2		he equipment	
EQ-202	Mobile Computer Station	TBD	335	NA	OFOI				
XEQ-001 XEQ-002	Tool box Cyro	Existing Existing	327	NA	OFCI OFCI	With operative Open RHS			
XEQ-003	Faraday box	Existing	327	NA	OFCI		-		ADJ. WALL
XEQ-004 XEQ-005	Faraday box Table	Existing Existing	327	NA NA	OFCI OFCI				GLAZED FACING TILE
XEQ-006	Full-height cabinet	Existing	327	NA	OFOI				GROUT FRAME SEALANT, BOT
XEQ-100 XEQ-101	Digital Scale 1 Digital scale 2	Existing Existing	333 333	120V 120V	OFCI OFCI		ertop, new loca ertop, new loca		SOLID, TYP
XEQ-101 XEQ-102	Sonic cleaner	Existing	333	120V 120V	OFCI		ertop, new loca		FRAME ANCHOR
XEQ-103	PH meter Side warmer	Existing	333		OFCI		ertop, new loca		
XEQ-104 XEQ-105	Side warmer Flammable storage	Existing Existing	333 333	120V NA	OFCI OFCI		ertop, new loca x, below count		BOLT WITH CAP
XEQ-106	Acid storage	Existing	333	NA	OFCI		below counter	•	SCHEDULED DOOR
XEQ-107 XEQ-108	Refrigerator Racks	Existing Existing	333	120V NA	OFCI OFCI	Quantity 2			DOOR
XEQ-109	Tank	Existing	333	NA	OFCI			eater in each tank	SEALANT, BOTH SIDES
XEQ-200 XEQ-201	Digital scale Circadian box 1	Existing Existing	333 333	120V 120V	OFCI OFCI	Cahinoth	as huilt_in over	aust but needs to have some	
						clearance	to accommod	ate the internal exhaust	
XEQ-202	Circadian box 2	Existing	333	120V	OFCI			aust but needs to have some ate the internal exhaust	$4 \frac{\text{DOOR JAMB DETAIL - EXISTING WALL}}{3" = 1'-0"}$
	Desktop computer	Existing	333	120V	OFCI	Quantity 2			
XEQ-204	Mobile metal table	Existing Existing	333 333	NA NA	OFCI OFCI	Quantity 2			EQUIPMENT LEGEND
XEQ-205	Bedding hin	LUISUIN							EQUIPMENT LEGENDJAN
	Bedding binFood hopper	Existing	333	NA	OFCI				
XEQ-205 XEQ-206 XEQ-207 XEQ-208	Food hopper Morris water maze	Existing	333	NA	OFCI			d when needed	CF CONTRACTOR FURNISHED CI CONTRACTOR INSTALLED
XEQ-205 XEQ-206 XEQ-207	Food hopper			NA NA		Quantity 2			CF CONTRACTOR FURNISHED CI CONTRACTOR INSTALLED OF OWNER FURNISHED OI OWNER INSTALLED HEAD 1 1/2" =


			R		CHEDULE			1 1		DOOR SCHEDULE
ROOM NUM	/BER R		EILING FINISH NORTH	WAL SOUTH	L FINISH EAST	WEST	FLOOR FINISH	BASE FINISH	COMMENTS	Yangyong Wind Width Yangyong Width Height Joor
327	PSYCH MA	RINE DIAGONISTIC A	CT-1 EXISTING	PT-2	PT-1 E	EXISTING	EPX-1	CB-1 EXIS	STING COLUMNS - PT1	
333				PT-2		EXISTING			STING COLUMNS - PT1	
335 335 A	PROCEDUF ANIMAL HO		CT-1 EXISTING WB, PT-1 PT-2	PT-2 PT-2		EXISTING PT-2		CB-1 EXIS	STING COLUMNS - PT1	327 PSYCH MARINE DIAGONISTIC LAB 327-A 4'-0" 7'-0" 1 3/4" AA WD MATCH EXISTING 1 327 PSYCH MARINE DIAGONISTIC LAB 327-B 3'-0" 7'-10" 1 3/4" A WD MATCH EXISTING 2
335 A 335 B	ANIMAL HO		WB, PT-1 PT-2	PT-2		PT-2		CB-1		327 PSYCH MARINE DIAGONISTIC LAB 345 4' - 0" 7' - 0" 2" A FRP MANUF. EXISTING
										333 PSYCH MARINE HOUSING 333 3'-6" 7'-10" 1-3/4" A WD MATCH EXISTING EXISTING
										335 PROCEDURE LAB 335 4' - 0" 7' - 10" 1 3/4" A WD MATCH EXISTING EXISTING
										335 A ANIMAL HOUSING 1 335-A 3' - 0" 7' - 10" 1 3/4" A WD MATCH EXISTING 1 335 B ANIMAL HOUSING 2 335-B 3' - 0" 7' - 10" 1 3/4" A WD MATCH EXISTING 1
MATERIAL			MATERIAL	ROOM FINISH L	EGEND					
TYPE / CODE	e Mater	IAL DESCRIPTION	MANUFACTURER		MANUFAC	TURER MODEL	, SIZE & COLC	DR	MATERIAL REMARKS	SEE SCHEDULE 2" SEE SCHEDULE 2"
ACT-1	ACOUSTICAL CE	ILING TILE	SEE SPEC 095113	2x2, WHITE					CLEAN ROOM TILE,	
CB-1	INTEGRAL COVE	BASE	SEE SPEC 096700	- STONEHEN	NGE(ROCKTREAL	D BASIS OF DE	SIGN)		SCRUBABLE	
EPX-1	EPOXY FLOOR F		SEE SPEC 096700	STONEHEN	VGE(ROCKTREAD			~		
PT-1 PT-2		AIN FIELD WALL COLOR			ite (Sherwin W Ndle (Sherwin '			1) <	LOW VOC	
PT-3 PT-4	EPOXY PAINT - E METAL CASEWC	DOOR FRAME COLOR	SEE SPEC 099123 SEE SPEC 123553	· · · ·	DE GRAY (SHERV KI (THERMO FISH	<u> </u>			LOW VOC	
SS-1	SOLID SURFACE		SEE SPEC 123553		E (FORMICA BASI					SCHE
			(CASEWORK SC	HEDULE					
TYPE	MODEL	DES	SCRIPTION	WIDTH	DEPTH	HEIGH	IT COUN	IT FINISI	H COMMENTS	
BC-1	115J6320	Flush Overlay Steel Base	e Cabinet	3' - 0"	1' - 9 1/8"	2' - 11 1/4"	2	PT-4	FOOT PADEL	
BC-2	029J832L	Flush Overlay Steel Base	Cabinet	5' - 0"	1' - 9 1/8"	2' - 11 1/4"	· 1	PT-4	CONTROL LOCK	DOOR TYPE: A DOOR TYPE: AA FRAME TYPE: 1
3C-3	106J632L	Flush Overlay Steel Base	Cabinet	3' - 0"	1' - 9 1/8"	2' - 11 1/4"	' 1	PT-4	LOCK	DOOR & FRAME TYPES
3C-4 3C-5	303J432L 306J8320	Flush Overlay Steel Base Flush Overlay Steel Base		2' - 0" 4' - 0"	1' - 9 1/8" 1' - 9 1/8"	2' - 11 1/4" 2' - 11 1/4"		PT-4 PT-4	LOCK	$\frac{8}{1/2"} = 1'-0"$
BC-6	341J432L	Flush Overlay Steel Base	Cabinet	2' - 0"	1' - 9 1/8"	2' - 11 1/4"		PT-4	LOCK	$ - 1/2 = 1 - 0 \qquad - 0 \qquad$
EC-1 FC-1	525J3680 806J792L	Flush Overlay Steel End		7/8" 3' - 6"	2' - 4 7/8" 1' - 10"	2' - 11 1/4" 7' - 0 5/8"	1	PT-4 PT-4	LOCK	VARIES, VIF (7 5/8" ASSUMED)
	806J892L	Flush Overlay Steel Tall (4' - 0"	1' - 10"	7' - 0 5/8"	2	PT-4	LOCK	SAW CUT THE BRICK TO ACCOMMODATE METAL
<s-1< td=""><td>FO Steel Kneespace</td><td>Flush Overlay Steel Knee</td><td>espace Panel and Rails</td><td></td><td>1' - 9 1/8"</td><td>2' - 11 1/4"</td><td>2</td><td>PT-4</td><td></td><td>ANGLE FLANGES.</td></s-1<>	FO Steel Kneespace	Flush Overlay Steel Knee	espace Panel and Rails		1' - 9 1/8"	2' - 11 1/4"	2	PT-4		ANGLE FLANGES.
LG-1	522J3610	Leg Assembly			1' - 9 5/8"	2' - 11 1/4"	1	PT-4		EXISTING GLAZED FACING TILE WALL, SAW CUT
PB-1 SC-1	52L80500 618J0340	Glassware Pegboard Flush Overlay Steel Filler	s and Scribes	1' - 6" 1"	2"	2' - 0" 2' - 11 1/4"		PT-4 PT-4		4" OR 6" MIN. BOTH SIDE
WC-1	702J423L	Flush Overlay Steel Wall	Cabinet	2' - 0"	1' - 1"	2' - 1 1/4"	1	PT-4	LOCK	SEALANT, BOTH SIDES TYP.
WC-2 WC-3	703J423L 706J523L	Flush Overlay Steel Wall Flush Overlay Steel Wall		2' - 0" 2' - 6"	1' - 1" 1' - 1"	2' - 1 1/4" 2' - 1 1/4"	4	PT-4 PT-4	LOCK	GROUT HEAD
WC-4	706J623L	Flush Overlay Steel Wall	Cabinet	3' - 0"	1' - 1"	2' - 1 1/4"	3	PT-4	LOCK	HM FRAME
WC-5	706J823L	Flush Overlay Steel Wall	Cabinet	4' - 0"	1' - 1"	2' - 1 1/4"	1	PT-4	LOCK	SCHEDULED DOOR DOO
<u>Note</u> : Basis	S OF DESIGN: THE	RMO FISHER SCIENTIFI	C, SEE SPEC SECTION 12355	3						WELD 5/16" THICK METAL PLATE TO THE ANGLE
			EQUIPMENT SCHEDULE	SEE ALSO SF	PECIFICATION S	ECTION 11 00 (0			
EQUIPMEN NUMBER		DESCRIPTION			POWER REQ					
NUIVIDER		IESCRIPTION		DOOM	POWERREQ	PROVIDED DI		COM	IVIEINIS	20 GA DOUE
FO 100			MANUFACTURER	ROOM				СОМ		
EQ-100 EQ-200			Aquatic Habitat, Benchtop	333	120V -10.5A	OFOI	(Owner filter	r). Future installati		$5 \frac{\text{DOOR HEAD DETAIL - EXISTING WALL}}{3" = 1'-0"} \xrightarrow{20 \text{ GA DOUE}}_{3" = 1'-0"}$
EQ-200 EQ-201	Bedding station Animal cage ra	1	Aquatic Habitat, Benchtop Techiplast, DS36 TBD	333 335 335	120V -10.5A 115V - 8.6 A NA	OFOI CFCI OFCI	(Owner filter			DOOR HEAD DETAIL - EXISTING WALL 3" = 1'-0"
EQ-200 EQ-201 EQ-202	Bedding station Animal cage ra Mobile Compu	n cks	Aquatic Habitat, Benchtop Techiplast, DS36 TBD TBD	333 335 335 335 335	115V - 8.6 A NA NA	OFOI CFCI OFCI OFOI	(Owner filter Exhaust and Quantity 2	r). Future installati d air filter in the equ		DOOR HEAD DETAIL - EXISTING WALL 3" = 1'-0"
EQ-200 EQ-201 EQ-202 XEQ-001 XEQ-002	Bedding station Animal cage ra Mobile Compu Tool box Cyro	n cks	Aquatic Habitat, Benchtop Techiplast, DS36 TBD	333 335 335 335 335 327 327	115V - 8.6 A NA NA NA -	OFOI CFCI OFCI OFOI OFCI OFCI	(Owner filter Exhaust and	r). Future installati d air filter in the equipted and the equinted and the equipted and the equipted and th		DOOR HEAD DETAIL - EXISTING WALL 3" = 1'-0"
EQ-200 EQ-201 EQ-202 XEQ-001 XEQ-002 XEQ-003	Bedding station Animal cage ra Mobile Compu Tool box Cyro Faraday box	n cks	Aquatic Habitat, Benchtop Techiplast, DS36 TBD TBD Existing Existing Existing Existing	333 335 335 335 327 327 327 327	115V - 8.6 A NA NA NA - NA	OFOI CFCI OFCI OFOI OFCI OFCI OFCI	(Owner filter Exhaust and Quantity 2 With operab	r). Future installati d air filter in the equipted and the equinted and the equipted and the equipted and th		5 DOOR HEAD DETAIL - EXISTING WALL 3" = 1'-0" ADJ. WALL EXISTING STRUCTURAL ASSEMBLY. RE FRAI STAGGER SC EACH VEI
EQ-200 EQ-201 EQ-202 XEQ-001 XEQ-002	Bedding station Animal cage ra Mobile Compu Tool box Cyro Faraday box Faraday box	n cks	Aquatic Habitat, Benchtop Techiplast, DS36 TBD TBD Existing Existing	333 335 335 335 335 327 327	115V - 8.6 A NA NA NA -	OFOI CFCI OFCI OFOI OFCI OFCI	(Owner filter Exhaust and Quantity 2 With operab	r). Future installati d air filter in the equipted and the equinted and the equipted and the equipted and th		5 DOOR HEAD DETAIL - EXISTING WALL ASSEMBLY. RE STAGGER SC 0 3" 6" ADJ. WALL ASSEMBLY. RE FRAI STAGGER SC EACH 0 3" 6"
EQ-200 EQ-201 EQ-202 XEQ-001 XEQ-002 XEQ-003 XEQ-004 XEQ-005 XEQ-006	Bedding stationAnimal cage raMobile ComputTool boxCyroFaraday boxFaraday boxTableFull-height cab	n cks ter Station	Aquatic Habitat, BenchtopTechiplast, DS36TBDTBDExistingExistingExistingExistingExistingExistingExistingExistingExistingExistingExistingExistingExistingExistingExistingExistingExistingExistingExisting	333 335 335 335 327 327 327 327 327 327 327 327 327	115V - 8.6 A NA NA NA - NA	OFOI CFCI OFCI OFCI OFCI OFCI OFCI OFCI	(Owner filter Exhaust and Quantity 2 With operab Open RHS	r). Future installati d air filter in the equiple lid		5 DOOR HEAD DETAIL - EXISTING WALL 3" = 1'-0" ADJ. WALL EXISTING STRUCTURAL GROUT FRAME GROUT FRAME ASSEMBLY. RE FRA STAGEER SC EACH VEI STAGEER SC EACH STAGEER SC EACH STAGEER SC STAGEER SC ST
EQ-200 EQ-201 EQ-202 XEQ-001 XEQ-002 XEQ-003 XEQ-004 XEQ-005	Bedding stationAnimal cage radiusMobile ComputTool boxCyroFaraday boxFaraday boxTableFull-height cabDigital Scale 1	inet	Aquatic Habitat, BenchtopTechiplast, DS36TBDTBDExistingExistingExistingExistingExistingExistingExistingExistingExistingExistingExistingExistingExistingExistingExisting	333 335 335 335 327 327 327 327 327 327 327	115V - 8.6 A NA NA NA - NA	OFOI CFCI OFCI OFOI OFCI OFCI OFCI OFCI	(Owner filter Exhaust and Quantity 2 With operab Open RHS	r). Future installati d air filter in the equipted and the equinted and the equipted and the equipted and th		5 DOOR HEAD DETAIL - EXISTING WALL 3" = 1'-0" ADJ. WALL EXISTING STRUCTURAL GLAZED FACING TILE GROUT FRAME SOLID, TYP SEALA
EQ-200 EQ-201 EQ-202 XEQ-001 XEQ-002 XEQ-003 XEQ-004 XEQ-005 XEQ-006 XEQ-100 XEQ-101 XEQ-102	Bedding stationAnimal cage raMobile ComputTool boxCyroFaraday boxFaraday boxTableFull-height cabDigital Scale 1Digital scale 2Sonic cleaner	inet	Aquatic Habitat, BenchtopTechiplast, DS36TBDTBDExisting	333 335 335 335 327 327 327 327 327 327 327 327 327 327	115V - 8.6 A NA 120V 120V 120V	OFOI CFCI OFCI OFCI OFCI OFCI OFCI OFCI	(Owner filter Exhaust and Quantity 2 With operab Open RHS Open RHS	r). Future installati d air filter in the equi- ole lid op, new location op, new location op, new location		DOOR HEAD DETAIL - EXISTING WALL 3" = 1'-0" ASSEMBLY. RE FRAM 0 3" 6" ASSEMBLY. RE FRAM STAGERSC EACH VEI GROUT FRAME GROUT FRAME SEALA FRAME ANCHOR SEALA
EQ-200 EQ-201 EQ-202 XEQ-001 XEQ-002 XEQ-003 XEQ-004 XEQ-005 XEQ-006 XEQ-100 XEQ-101	Bedding station Animal cage radius Mobile Compute Tool box Cyro Faraday box Faraday box Faraday box Full-height cab Digital Scale 1 Digital scale 2 Sonic cleaner PH meter	inet	Aquatic Habitat, BenchtopTechiplast, DS36TBDTBDExisting	333 335 335 335 327 327 327 327 327 327 327 327 327 327	115V - 8.6 A NA NA NA - NA NA NA NA NA NA 120V 120V	OFOI CFCI OFCI OFCI OFCI OFCI OFCI OFCI	(Owner filter Exhaust and Quantity 2 With operab Open RHS On counterte On counterte On counterte On counterte On counterte On counterte	r). Future installati d air filter in the equiple lid op, new location op, new location		5 DOOR HEAD DETAIL - EXISTING WALL 3" = 1'-0" ADJ. WALL CALARD FRAME STAGERS C EACH VEI CALARD FRAME STAGERS C EACH VEI STAGERS C EACH VEI STAGERS C CALARD FRAME STAGERS C EACH VEI STAGERS C STAGERS C S
EQ-200 EQ-201 EQ-202 XEQ-001 XEQ-002 XEQ-003 XEQ-004 XEQ-004 XEQ-005 XEQ-006 XEQ-100 XEQ-101 XEQ-101 XEQ-102 XEQ-103 XEQ-104 XEQ-105	Bedding station Animal cage radio Mobile Computing Tool box Cyro Faraday box Faraday box Faraday box Faraday box Digital Scale 1 Digital Scale 2 Sonic cleaner PH meter Side warmer Flammable sto	n cks ter Station	Aquatic Habitat, BenchtopTechiplast, DS36TBDTBDExisting	333 335 335 335 327 327 327 327 327 327 327 327 327 327	115V - 8.6 A NA 120V 120V 120V 120V 120V NA NA NA	OFOI CFCI OFCI OFCI OFCI OFCI OFCI OFCI	(Owner filter Exhaust and Quantity 2 With operab Open RHS On counterte O	r). Future installati d air filter in the equi- ble lid op, new location op, new location op, new location op, new location op, new location op, new location op, new location below countertop	uipment	5 DOOR HEAD DETAIL - EXISTING WALL 3" = 1'-0" ADJ. WALL EXISTING STRUCTURAL GLAZED FACING TILE FRAME ANCHOR HM FRAME COUNTERSUNK FLATHEAD BNC LIWITH CAP
EQ-200 EQ-201 EQ-202 XEQ-001 XEQ-002 XEQ-003 XEQ-004 XEQ-005 XEQ-006 XEQ-100 XEQ-101 XEQ-101 XEQ-102 XEQ-103 XEQ-104	Bedding stationAnimal cage raMobile ComputTool boxCyroFaraday boxFaraday boxFaraday boxFaraday boxFull-height cabDigital Scale 1Digital Scale 2Sonic cleanerPH meterSide warmerFlammable stoAcid storage	n cks ter Station	Aquatic Habitat, BenchtopTechiplast, DS36TBDTBDExisting	333 335 335 327 327 327 327 327 327 327 327 327 327	115V - 8.6 A NA NA NA - NA NA NA NA NA 120V 120V 120V 120V 120V 120V 120V 120V 120V	OFOI CFCI OFCI OFCI OFCI OFCI OFCI OFCI	(Owner filter Exhaust and Quantity 2 With operab Open RHS On counterte O	r). Future installati d air filter in the equi- ole lid op, new location op, new location op, new location op, new location op, new location op, new location	uipment	5 DOOR HEAD DETAIL - EXISTING WALL 3" = 1'-0" ADJ. WALL CALARD FRAME STAGERS C EACH VEI CALARD FRAME STAGERS C EACH VEI STAGERS C EACH VEI STAGERS C CALARD FRAME STAGERS C EACH VEI STAGERS C STAGERS C S
EQ-200 EQ-201 EQ-202 XEQ-001 XEQ-002 XEQ-003 XEQ-004 XEQ-004 XEQ-005 XEQ-006 XEQ-100 XEQ-100 XEQ-101 XEQ-102 XEQ-103 XEQ-104 XEQ-105 XEQ-106 XEQ-107 XEQ-108	Bedding stationAnimal cage raMobile ComputTool boxCyroFaraday boxFaraday boxFaraday boxFaraday boxFaraday boxFaraday boxFaraday boxDigital Scale 1Digital Scale 1Digital Scale 2Sonic cleanerPH meterSide warmerFlammable stoAcid storageRacks	n cks ter Station	Aquatic Habitat, BenchtopTechiplast, DS36TBDTBDExisting	333 335 335 327 327 327 327 327 327 327 327 327 327	115V - 8.6 A NA 120V NA NA <t< td=""><td>OFOI CFCI OFCI OFCI</td><td>(Owner filter Exhaust and Quantity 2 With operab Open RHS On counterto Ountity 2</td><td>r). Future installati d air filter in the equi- ble lid op, new location op, new location op, new location op, new location op, new location op, new location below countertop</td><td></td><td>5 DOOR HEAD DETAIL - EXISTING WALL 3" = 1'-0" ADJ WALL</td></t<>	OFOI CFCI OFCI	(Owner filter Exhaust and Quantity 2 With operab Open RHS On counterto Ountity 2	r). Future installati d air filter in the equi- ble lid op, new location op, new location op, new location op, new location op, new location op, new location below countertop		5 DOOR HEAD DETAIL - EXISTING WALL 3" = 1'-0" ADJ WALL
EQ-200 EQ-201 EQ-202 XEQ-001 XEQ-002 XEQ-003 XEQ-004 XEQ-005 XEQ-006 XEQ-006 XEQ-100 XEQ-101 XEQ-101 XEQ-102 XEQ-103 XEQ-104 XEQ-105 XEQ-106 XEQ-107	Bedding stationAnimal cage raMobile ComputTool boxCyroFaraday boxFaraday boxFaraday boxFaraday boxFaraday boxFaraday boxFaraday boxFaraday boxDigital Scale 1Digital Scale 1Digital Scale 2Sonic cleanerPH meterSide warmerFlammable stoAcid storageRacksTank	n cks ter Station	Aquatic Habitat, BenchtopTechiplast, DS36TBDTBDExisting	333 335 335 327 327 327 327 327 327 327 327 327 327	115V - 8.6 A NA 120V 120V 120V NA NA NA 120V 120V NA NA NA 120V 120V 120V 120V 120V 120V NA NA NA NA NA NA NA	OFOI CFCI OFCI OFCI OFCI OFCI OFCI OFCI	(Owner filter Exhaust and Quantity 2 With operab Open RHS On counterto Ountity 2	r). Future installati d air filter in the equi- ble lid op, new location op, new location op, new location op, new location op, new location op, new location op, new location below countertop		5 DOOR HEAD DETAIL - EXISTING WALL 3" = 1'-0" ADJ WALL
EQ-200 EQ-201 EQ-202 XEQ-001 XEQ-002 XEQ-003 XEQ-004 XEQ-004 XEQ-006 XEQ-006 XEQ-100 XEQ-100 XEQ-101 XEQ-102 XEQ-103 XEQ-104 XEQ-105 XEQ-106 XEQ-107 XEQ-108 XEQ-109	Bedding stationAnimal cage raMobile ComputTool boxCyroFaraday boxFaraday boxTableFull-height cabDigital Scale 1Digital Scale 2Sonic cleanerPH meterSide warmerFlammable stoAcid storageRacksTankDigital scale	n cks ter Station	Aquatic Habitat, BenchtopTechiplast, DS36TBDTBDExisting	333 335 335 335 327 327 327 327 327 327 327 327 327 327	115V - 8.6 A NA 120V 120V 120V NA N	OFOI CFCI OFCI	(Owner filter Exhaust and Quantity 2 With operab Open RHS On counterto Ouantity 2 Quantity 10, Cabinet has	r). Future installati d air filter in the equal ole lid op, new location op, new location op, new location op, new location op, new location op, new location op, new location below countertop elow countertop	uipment	5 DOOR HEAD DETAIL - EXISTING WALL 3" = 1'-0"
EQ-200 EQ-201 EQ-202 XEQ-001 XEQ-002 XEQ-003 XEQ-004 XEQ-005 XEQ-006 XEQ-100 XEQ-100 XEQ-101 XEQ-102 XEQ-103 XEQ-103 XEQ-104 XEQ-105 XEQ-106 XEQ-107 XEQ-108 XEQ-109 XEQ-200	Bedding stationAnimal cage rayMobile ComputTool boxCyroFaraday boxFaraday boxFaraday boxTableFull-height cabDigital Scale 1Digital Scale 2Sonic cleanerPH meterSide warmerFlammable stoAcid storageRacksTankDigital scaleCircadian box	n cks ter Station inet rage	Aquatic Habitat, BenchtopTechiplast, DS36TBDTBDExisting	333 335 335 327 327 327 327 327 327 327 327 327 327	115V - 8.6 A NA 120V 120V 120V NA NA NA NA NA NA 120V NA NA <td< td=""><td>OFOI CFCI OFCI OFCI</td><td>(Owner filter Exhaust and Quantity 2 With operab Open RHS On counterto Ouantity 2 Quantity 10, Cabinet has Cabinet has Cabinet has</td><td>r). Future installati d air filter in the equal ole lid op, new location op, new location op, new location op, new location op, new location op, new location op, new location below countertop elow countertop</td><td>uipment</td><td>5 DOOR HEAD DETAIL - EXISTING WALL 3" = 1'-0"</td></td<>	OFOI CFCI OFCI OFCI	(Owner filter Exhaust and Quantity 2 With operab Open RHS On counterto Ouantity 2 Quantity 10, Cabinet has Cabinet has Cabinet has	r). Future installati d air filter in the equal ole lid op, new location op, new location op, new location op, new location op, new location op, new location op, new location below countertop elow countertop	uipment	5 DOOR HEAD DETAIL - EXISTING WALL 3" = 1'-0"
EQ-200 EQ-201 EQ-202 XEQ-001 XEQ-002 XEQ-003 XEQ-004 XEQ-005 XEQ-006 XEQ-100 XEQ-100 XEQ-101 XEQ-102 XEQ-103 XEQ-104 XEQ-105 XEQ-106 XEQ-107 XEQ-108 XEQ-109 XEQ-200 XEQ-201	Bedding station Animal cage radio Mobile Comput Tool box Cyro Faraday box Digital Scale 1 Digital Scale 2 Sonic cleaner PH meter Side warmer Flammable sto Acid storage Refrigerator Racks Tank Digital scale Circadian box	n cks ter Station	Aquatic Habitat, BenchtopTechiplast, DS36TBDTBDExisting	333 335 335 327 327 327 327 327 327 327 327 327 327	115V - 8.6 A NA 120V 120V 120V NA NA NA NA NA 120V NA NA NA NA NA NA NA 120V NA 120V 120V 120V NA 120V	OFOI CFCI OFCI OFCI	(Owner filter Exhaust and Quantity 2 With operab Open RHS On counterto Ouantity 2 Quantity 10, Cabinet has Cabinet has Cabinet has	r). Future installati d air filter in the equal ole lid op, new location op, new location op, new location op, new location op, new location op, new location op, new location below countertop elow countertop	uipment	5 DOOR HEAD DETAIL - EXISTING WALL 3" = 1'-0" ADJ WALL
EQ-200 EQ-201 EQ-202 XEQ-001 XEQ-002 XEQ-003 XEQ-004 XEQ-006 XEQ-006 XEQ-100 XEQ-100 XEQ-101 XEQ-102 XEQ-103 XEQ-103 XEQ-104 XEQ-105 XEQ-106 XEQ-107 XEQ-106 XEQ-107 XEQ-108 XEQ-109 XEQ-200 XEQ-201 XEQ-201 XEQ-202	Bedding stationAnimal cage raMobile ComputTool boxCyroFaraday boxFaraday boxFaraday boxFaraday boxFaraday boxFaraday boxFaraday boxFaraday boxDigital Scale 1Digital Scale 1Digital Scale 2Sonic cleanerPH meterSide warmerFlammable stoAcid storageRefrigeratorRacksTankDigital scaleCircadian box 1Circadian box 2Desktop compliantMobile metal ta	n cks ter Station inet rage 1 2 Jter	Aquatic Habitat, BenchtopTechiplast, DS36TBDTBDExisting	333 335 335 335 327 327 327 327 327 327 327 327 327 327 323 333 3	115V - 8.6 A NA 120V 120V NA NA NA NA NA NA 120V NA NA NA 120V NA NA <td< td=""><td>OFOI CFCI OFCI OFCI</td><td>(Owner filter Exhaust and Quantity 2 With operability Open RHS On countertor Outantity 2 Quantity 10, Cabinet has clearance to Cabinet has clearance to</td><td>r). Future installati d air filter in the equal ole lid op, new location op, new location op, new location op, new location op, new location op, new location op, new location below countertop elow countertop</td><td>uipment</td><td>BOOR HEAD DETAIL - EXISTING WALL 3" = 1'-0"</td></td<>	OFOI CFCI OFCI	(Owner filter Exhaust and Quantity 2 With operability Open RHS On countertor Outantity 2 Quantity 10, Cabinet has clearance to Cabinet has clearance to	r). Future installati d air filter in the equal ole lid op, new location op, new location op, new location op, new location op, new location op, new location op, new location below countertop elow countertop	uipment	BOOR HEAD DETAIL - EXISTING WALL 3" = 1'-0"
EQ-200 EQ-201 EQ-202 XEQ-001 XEQ-002 XEQ-003 XEQ-004 XEQ-005 XEQ-006 XEQ-100 XEQ-100 XEQ-101 XEQ-102 XEQ-103 XEQ-104 XEQ-105 XEQ-106 XEQ-107 XEQ-108 XEQ-107 XEQ-108 XEQ-109 XEQ-200 XEQ-200 XEQ-201 XEQ-202	Bedding station Animal cage radio Mobile Computing Tool box Cyro Faraday box Table Full-height cab Digital Scale 1 Digital scale 2 Sonic cleaner PH meter Side warmer Side warmer Flammable sto Acid storage Refrigerator Racks Tank Digital scale Circadian box 1 Desktop computies Mobile metal tate Bedding bin	n cks ter Station inet rage 1 2 Jter	Aquatic Habitat, BenchtopTechiplast, DS36TBDTBDExisting	333 335 335 335 327 327 327 327 327 327 327 327 323 333 3	115V - 8.6 A NA 120V 120V 120V NA NA NA NA 120V NA NA NA 120V NA NA NA NA 120V NA NA NA NA NA NA 120V NA 120V 120V 120V 120V 120V 120V	OFOI CFCI OFCI OFCI	(Owner filter Exhaust and Quantity 2 With operable Open RHS On counterter Quantity 2 Quantity 10, Cabinet has clearance to Quantity 2 Quantity 10,	r). Future installati d air filter in the equal ole lid op, new location op, new location op, new location op, new location op, new location op, new location op, new location below countertop elow countertop	uipment	DOOR HEAD DETAIL - EXISTING WALL 3" = 1'-0"
EQ-200 EQ-201 EQ-202 XEQ-001 XEQ-003 XEQ-004 XEQ-004 XEQ-006 XEQ-100 XEQ-100 XEQ-100 XEQ-102 XEQ-103 XEQ-103 XEQ-104 XEQ-105 XEQ-106 XEQ-107 XEQ-108 XEQ-109 XEQ-200 XEQ-201 XEQ-201 XEQ-201 XEQ-202	Bedding stationAnimal cage rayMobile ComputTool boxCyroFaraday boxFaraday boxFull-height cabDigital Scale 1Digital scale 2Sonic cleanerFlammable stoAcid storageFlammable stoAcid storageRefrigeratorRacksTankDigital scaleCircadian box 1Circadian box 2Circadian box 3Desktop compliantMobile metal tabBedding binFood hopperMorris water metal	n cks ter Station inet inet inet inet inet inet inet ine	Aquatic Habitat, BenchtopTechiplast, DS36TBDTBDExisting	333 335 335 335 327 323 333 3	115V - 8.6 A NA 120V 120V NA NA NA NA NA 120V NA NA NA NA 120V NA NA <td< td=""><td>OFOI CFCI OFCI OFCI</td><td>(Owner filter Exhaust and Quantity 2 With operability Open RHS Open RHS On countertor Quantity 2 Quantity 10, Cabinet has clearance to Quantity 2 Quantity 2</td><td>r). Future installati d air filter in the equal ole lid op, new location op, new location op, new location op, new location op, new location op, new location op, new location below countertop elow countertop</td><td>uipment</td><td>Source of the second of the se</td></td<>	OFOI CFCI OFCI OFCI	(Owner filter Exhaust and Quantity 2 With operability Open RHS Open RHS On countertor Quantity 2 Quantity 10, Cabinet has clearance to Quantity 2	r). Future installati d air filter in the equal ole lid op, new location op, new location op, new location op, new location op, new location op, new location op, new location below countertop elow countertop	uipment	Source of the second of the se
EQ-200 EQ-201 EQ-202 XEQ-001 XEQ-002 XEQ-003 XEQ-004 XEQ-004 XEQ-006 XEQ-100 XEQ-100 XEQ-100 XEQ-101 XEQ-102 XEQ-103 XEQ-104 XEQ-105 XEQ-106 XEQ-107 XEQ-108 XEQ-109 XEQ-200 XEQ-201 XEQ-201 XEQ-202	Bedding stationAnimal cage rayMobile ComputTool boxCyroFaraday boxFaraday boxFaraday boxTableFull-height cabDigital Scale 1Digital Scale 2Sonic cleanerPH meterSide warmerFlammable stoAcid storageRefrigeratorRacksTankDigital scaleCircadian box fCircadian box fMobile metal taBedding binKorris water mCage rack	n cks ter Station inet inet inet inet inet inet inet ine	Aquatic Habitat, BenchtopTechiplast, DS36TBDTBDExisting	333 335 335 335 327 327 327 327 327 327 327 327 323 333 3	115V - 8.6 A NA 120V 120V 120V NA NA NA NA NA 120V NA NA NA 120V NA 120V 120V 120V 120V 120V NA NA NA NA NA NA NA <t< td=""><td>OFOI CFCI OFCI OFCI</td><td>(Owner filter Exhaust and Quantity 2 With operable Open RHS On counterter Ouantity 2 Quantity 10, Cabinet has clearance to Cabinet has clearance to Quantity 2 Quantity 2 Quantity 2 Quantity 2 Quantity 2</td><td>r). Future installati d air filter in the equal ole lid op, new location op, new location below countertop elow countertop</td><td>uipment</td><td>Solution to the state of the st</td></t<>	OFOI CFCI OFCI OFCI	(Owner filter Exhaust and Quantity 2 With operable Open RHS On counterter Ouantity 2 Quantity 10, Cabinet has clearance to Cabinet has clearance to Quantity 2 Quantity 2 Quantity 2 Quantity 2 Quantity 2	r). Future installati d air filter in the equal ole lid op, new location op, new location below countertop elow countertop	uipment	Solution to the state of the st

		R	ROOM FINISH SC															DOOR S	CHEDULE		
ROOM NUM	ABER ROOM NAME C	EILING FINISH NORTH	WAL SOUTH	L FINISH EAST	WEST	FLOOR FINISH	BASE FINISH	COMMENTS	NUMBER				NUMBER				DOOR				
327	PSYCH MARINE DIAGONISTIC A	CT-1 EXISTING	PT-2	PT-1 E	EXISTING	EPX-1	CB-1	EXISTING COLUMNS - PT1	ROOM N		ROOM NAM	1	DOOR N	WIDTH	I HEIGHT			ATERI AL FINI	сП	TYPE	
333		CT-1 EXISTING	PT-2		XISTING	EPX-1		EXISTING COLUMNS - PT1							-1						
335 335 A		CT-1 EXISTING WB, PT-1 PT-2	PT-2 PT-2		EXISTING PT-2	EPX-1 EPX-1	CB-1 CB-1	EXISTING COLUMNS - PT1	327	\rightarrow	HMARINE DIAGO	/		4' - 0" 3' - 0"	7' - 0* 7' - 10"	1 3/4"	AA WI			$\frac{1}{2}$	Ē
335 B	ANIMAL HOUSING 2 G	WB, PT-1 PT-2	PT-2	PT-2 P	PT-2	EPX-1	CB-1		327		H MARINE DIAGO				7' - 0"	2"	A FR			EXISTING	; E
									333		LMARINE HOUS	ING	333	3' - 6"	7' - 10"	13/4"	A W	D MATCH EX	ISTING	EXISTIN	
									335 335 /	A ANIMA	EDURE LAB L HOUSING 1		335 335-A	4' - 0" 3' - 0"	7' - 10" 7' - 10"	1 3/4" 1 3/4"	A W	D MATCH EX	(ISTING	1	ŀ
MATERIAL		MATERIAL	ROOM FINISH L	EGEND					335	B ANIMA	L HOUSING 2		335-B	3' - 0"	7' - 10"	1 3/4"	A W	D MATCH EX	(ISTING	1	ŀ
TYPE / CODE		MANUFACTURER		MANUFACT	URER MODEL	, SIZE & COLO	OR	MATERIAL REMARK	S		SEE SCHE	EDULE			3' - 0"	. 1' - 0" .		2" SEE SCHEDU	JLE 2"		
ACT-1	ACOUSTICAL CEILING TILE	SEE SPEC 095113	2x2, WHITE					CLEAN ROOM TILE,		<u>+</u>		/ /	1	/			₹∨2			4 	
CB-1	INTEGRAL COVE BASE	SEE SPEC 096700	STONEHEN	IGE(ROCKTREAD) BASIS OF DE	SIGN)		SCRUBABLE													
EPX-1 PT-1	EPOXY FLOOR FINISH EPOXY PAINTMAIN FIELD WALL COLOR	SEE SPEC 096700	STONETHEN	IGE(ROCKTREAD TE (SHERWIN WI				LOW VOC			/	1 200			1 P						
PT-2	EPOXY PAOINT ACCENT WALL COLOR	SEE SPEC 099123	FAWN BRI	IDLE (SHERWIN \	WILLIAMS BAS	IS OF DESIGN	V) 5	LOW VOC		щ			ш	1			ш			ш	
PT-3 PT-4	EPOXY PAINT - DOOR FRAME COLOR METAL CASEWORK COLOR	SEE SPEC 099123 SEE SPEC 123553	DARK KHA	DE GRAY (SHERW KH (THERMO FISH	HER BASIS OF			LOW VOC		HEDUL			HEDUL				TEDUL			HEDUL	
SS-1	SOLID SURFACE COUNTER	SEE SPEC 123553	SMOKE ICE	E (FORMICA BASI	S OF DESIG)					EE SCI			EE SCI		_		EE SCH			EE SCI	
										S			S	Ì.			S			S	
		(CASEWORK SC	HEDULE												/					
TYPE	MODEL DES	SCRIPTION	WIDTH	DEPTH	HEIGH	T COUN	NT FI	NISH COMMENTS							```						
BC-1	115J6320Flush Overlay Steel Base	e Cabinet	3' - 0"	1' - 9 1/8"	2' - 11 1/4"	2	PT-4	FOOT PADEL		+		``			۸ ۸		+		U	<u>_</u>	
BC-2	029J832L Flush Overlay Steel Base		5' - 0"	1' - 9 1/8"	2' - 11 1/4"		PT-4	CONTROL LOCK		<u>DO</u>	<u>OR TYPE: A</u>		DOC	<u>)r type: .</u>	<u>AA</u>		<u>FRA</u>	AME TYPE: 1		<u> </u> 	RAN (NO
BC-3 BC-4	106J632LFlush Overlay Steel Base303J432LFlush Overlay Steel Base		3' - 0" 2' - 0"	1' - 9 1/8" 1' - 9 1/8"	2' - 11 1/4" 2' - 11 1/4"		PT-4 PT-4	LOCK LOCK			OOR &	FRAM	ИЕТ	YPE	ES						
BC-5	306J8320 Flush Overlay Steel Base	e Drawers	4' - 0"	1' - 9 1/8"	2' - 11 1/4"	1	PT-4 PT-4	LOCK	(8 1/	2" = 1'-0"									1	VARIE
BC-6 EC-1	341J432LFlush Overlay Steel Base525J3680Flush Overlay Steel End	Support Panel	2' - 0" 7/8"	1' - 9 1/8" 2' - 4 7/8"	2' - 11 1/4" 2' - 11 1/4"		PT-4					VARI	0 ES, VIF (7 5/8	6" " ASSUMED)							F
FC-1 FC-2	806J792LFlush Overlay Steel Tall (806J892LFlush Overlay Steel Tall (3' - 6" 4' - 0"	1' - 10" 1' - 10"	7' - 0 5/8" 7' - 0 5/8"	2	PT-4 PT-4	LOCK LOCK				1	A	L	AC	W CUT THE BRICK					
KS-1	FO Steel Flush Overlay Steel Knee Kneespace			1' - 9 1/8"	2' - 11 1/4"	2	PT-4						//		AN	IGLE FLANGES.				1/2"	
LG-1	522J3610 Leg Assembly		11 (11	1' - 9 5/8"	2' - 11 1/4"	1	PT-4			EXISTI TILE W	ING GLAZED FACING VALL, SAW CUT		a 		AN AN	-1/2x3-1/2x5/16 MET. IGLE LINTEL, EXTEN	ND			+	E
PB-1 SC-1	52L80500Glassware Pegboard618J0340Flush Overlay Steel Filler	rs and Scribes	1' - 6" 1"	1" 2"	2' - 0" 2' - 11 1/4"	6	PT-4 PT-4			OPENI OVER	ING TYP. DO NOT CUT.		<u> </u>	· · · · · · · · · · · · · · · · · · ·		or 6" min. Both Sii The Door.	DE		ē		
WC-1 WC-2	702J423LFlush Overlay Steel Wall703J423LFlush Overlay Steel Wall		2' - 0" 2' - 0"	1' - 1" 1' - 1"	2' - 1 1/4" 2' - 1 1/4"	1	PT-4 PT-4	LOCK LOCK		SEALA SIDES	ANT, BOTH 5 TYP.		4	1 A :							
WC-3	706J523L Flush Overlay Steel Wall	Cabinet	2' - 6"	1' - 1" 1' - 1"	2' - 1 1/4"	4	PT-4				IT HEAD										
WC-4 WC-5	706J623LFlush Overlay Steel Wall706J823LFlush Overlay Steel Wall		3' - 0" 4' - 0"	1' - 1"	2' - 1 1/4" 2' - 1 1/4"	1	PT-4 PT-4	LOCK LOCK					4.4.4.	A	4						
<u>note</u> : Basi:	S OF DESIGN: THERMO FISHER SCIENTIFIC	C, SEE SPEC SECTION 1235	53										4	a	WE	ELD 5/16" THICK ME ⁻	TAL		(3)	DOC	
													Λ		PL	ATE TO THE ANGLE			0	3" =	1'-
EQUIPMEN		EQUIPMENT SCHEDULE										1111_	_	/					2	20 ga doub	E ME
NUMBER	DESCRIPTION	MANUFACTURER	ROOM	POWER REQ	PROVIDED BY	,	C	COMMENTS	(5 D	DOR HI		DET	AIL -	- EXI	STING	WA	LL	ASS	EMBLY. REF FRAN AGGER SCI	ER T(
EQ-100 EQ-200		Aquatic Habitat, Benchtop Techiplast, DS36	333 335	120V -10.5A 115V - 8.6 A	OFOI CFCI	•	er). Future instand d air filter in the			<u> </u>	' = 1'-0"							6"	51	EACHS	
EQ-201	Animal cage racks	TBD	335	NA	OFCI	Quantity 2		c cquipment								Ŭ	5	U		-	
EQ-202 XEQ-001	•	TBD Existing	335 327	NA NA	OFOI OFCI	With operat	ole lid													- (4 7/8")	ļ
XEQ-002 XEQ-003		Existing Existing	327 327	- NA	OFCI OFCI	Open RHS						-		ADJ. W						RIES, VII	
XEQ-004	Faraday box	Existing	327	NA	OFCI								A"	EXISTI GLAZE	ING STRUCTUR ED FACING TILE	AL					•
XEQ-005 XEQ-006	Full-height cabinet	Existing Existing	327 327	NA NA	OFCI OFOI						I	1	4/				JT FRAME			SEALA	1 DU
XEQ-100 XEQ-101		Existing Existing	333 333	120V 120V	OFCI OFCI		top, new location top, new location									SC	olid, typ		I		
XEQ-102 XEQ-103	2 Sonic cleaner	Existing Existing	333 333	120V 120V	OFCI OFCI	On counter	top, new location	on			SSUME	a a					M FRAME		2	DO(3" =	
XEQ-104	Side warmer	Existing	333	120V	OFCI	On counter	top, new location top, new location top, new location to the second second second second second second second s	on			(7 5/8" A	4 4				COUNTERSUNK F	LATHEAD WITH CAP			J =	1 -
XEQ-105 XEQ-106		Existing Existing	333 333	NA NA	OFCI OFCI		below counter elow counterto	•			IES, VIF					I	HEDULED				
XEQ-107	Refrigerator	Existing	333 333	120V NA	OFCI OFCI	Quantity 2					VARI						DOOR				
XEQ-109	D Tank	Existing	333	NA	OFCI		, filter and heat	ter in each tank			SEALANT, BOT	TH SIDES									4
XEQ-200 XEQ-201		Existing Existing	333 333	120V 120V	OFCI OFCI			ist but needs to have some													
XEQ-202	2 Circadian box 2	Existing	333	120V	OFCI	Cabinet has	s built-in exhau	e the internal exhaust ist but needs to have some			DOR JA		DET	AIL -	- EXI	STING	WA	LL	N		
						clearance to		e the internal exhaust	(' = 1'-0"						3"	6"			×
XEQ-205	Mobile metal table	Existing	333	NA	OFCI	Quantity 2										U	J	J			
XEQ-207	/ Food hopper	Existing	333	NA	OFCI																JA
XEQ-208 XEQ-209		Existing Existing	333 333	NA NA	OFCI OFCI	Stored in closed Stored Stored In closed Stored In Closed Stores (Storegy 2) Stores (Stor	oset and used	when needed	CI CON	TRACTOR INS	STALLED										
XEQ-210		Existing	333	-	OFCI		ent next to sca	le		IER FURNISHE IER INSTALLE									··	1 1/2	<u>'</u> " =
XEQ-107 XEQ-108 XEQ-109 XEQ-200 XEQ-201 XEQ-201 XEQ-202 XEQ-204 XEQ-205 XEQ-206 XEQ-206 XEQ-207 XEQ-208 XEQ-209	 Refrigerator Racks Tank Digital scale Circadian box 1 Circadian box 2 Circadian box 2 Desktop computer Mobile metal table Bedding bin Food hopper Morris water maze Cage rack 	Existing Existing	333 333	120V NA NA 120V 120V 120V 120V 120V NA NA	OFCI OFCI OFCI OFCI OFCI OFCI OFCI OFCI	Quantity 2 Quantity 10 Cabinet has clearance to Cabinet has clearance to Quantity 2 Quantity 2 Stored in cle Quantity 2), filter and heat s built-in exhau o accommodate s built-in exhau o accommodate	ter in each tank ist but needs to have some ie the internal exhaust ist but needs to have some ie the internal exhaust when needed	CF CON CI CON OF OWN	3" MENT L TRACTOR FUI TRACTOR INS IER FURNISHE	SEALANT, BOT SEALANT, BOT OOR JA ' = 1'-0" LEGEND RNISHED STALLED ED		DET		_ EXI:	STING	DOOR	6"			HEA 1 1/2

		RU	DOM FINISH SC	CHEDULE			DOOR SCHEDULE	-
ROOM NUN	MBER ROOM NAME	CEILING FINISH NORTH	WAL SOUTH	L FINISH EAST	WEST	FLOOR BASE FINISH FINISH COMMENTS	DOOR	
27	PSYCH MARINE DIAGONISTIC	ACT-1 EXISTING	PT-2	PT-1 EX	XISTING	EPX-1 CB-1 EXISTING COLUMNS - PT1	중 Kanal Kan	
33	PSYCH MARINE HOUSING				XISTING	EPX-1 CB-1 EXISTING COLUMNS - PT1		TYPE
35 35 A	PROCEDURE LAB ANIMAL HOUSING 1				XISTING T-2	EPX-1CB-1EXISTING COLUMNS - PT1EPX-1CB-1	22 327 PSYCH MARINE DIAGONISTIC LAB 327-A 4'-6" 7'-0" 1 3/4" AA WD MATCH EXISTING 327 PSYCH MARINE DIAGONISTIC LAB 327-A 4'-6" 7'-0" 1 3/4" AA WD MATCH EXISTING 327 PSYCH MARINE DIAGONISTIC LAB 327-B 3'-0" 7'-10" 1 3/4" A WD MATCH EXISTING	V.
35 B	ANIMAL HOUSING 2	GWB, PT-1 PT-2	PT-2	PT-2 P	T-2	EPX-1 CB-1	327 PSYCH MARINE DIAGONISTIC LAB 345 4' - 0" 7' - 0" 2" A FRP MANUF. STANDARD A	
							333 PSYCH MARINE HOUSING 333 3' - 6" 7' - 10" 1 3/4" A WD MATCH EXISTING 335 PROCEDURE LAB 335 4' - 0" 7' - 10" 1 3/4" A WD MATCH EXISTING	
							335 A ANIMAL HOUSING 1 335-A 3' - 0" 7' - 10" 1 3/4" A WD MATCH EXISTING	1
MATERIAL		F MATERIAL	ROOM FINISH L	EGEND			335 B ANIMAL HOUSING 2 335-B 3' - 0" 7' - 10" 1 3/4" A WD MATCH EXISTING	1
YPE / CODI		MANUFACTURER		MANUFACTU	JRER MODEL,	SIZE & COLOR MATERIAL REMARKS	SEE SCHEDULE 3' - 0" 1' - 0" 2" SEE SCHEDULE 2"	-
CT-1	ACOUSTICAL CEILING TILE	SEE SPEC 095113	2x2, WHITE			CLEAN ROOM TILE, SCRUBABLE		4
3-1	INTEGRAL COVE BASE EPOXY FLOOR FINISH	SEE SPEC 096700 2 - SEE SPEC 096700				IGN)		
PX-1 T-1	EPOXY PAINTMAIN FIELD WALL CO	OR SEE SPEC 099123	EIDER WHI	GE(ROCKTREAD) TE (SHERWIN WIL	LIAMS BASIS (DF DESIGN)		
Т-2 Т-3	EPOXY PAOINT ACCENT WALL COL EPOXY PAINT - DOOR FRAME COLOF		COLLONAD		IN WILLIAM BAS	SSIS OF DESGIN) { LOW VOC		OLE
-4 5-1	METAL CASEWORK COLOR SOLID SURFACE COUNTER	SEE SPEC 123553 SEE SPEC 123553		KH (THERMO FISH E (FORMICA BASIS		ESIGN)		SCHEDI
								SEE
TYPE	MODEL	C DESCRIPTION	ASEWORK SC	HEDULE DEPTH	HEIGHT	COUNT FINISH COMMENTS		
				_				\mathbf{x}
;-1	115J6320 Flush Overlay Steel E 020 18221 Elush Overlay Steel E		3' - 0"	1' - 9 1/8"	2' - 11 1/4"	2 PT-4 FOOT PADEL CONTROL	DOOR TYPE: A DOOR TYPE: AA FRAME TYPE: 1	<u>FR</u> KN
-2 -3	029J832LFlush Overlay Steel E106J632LFlush Overlay Steel E	ase Cabinet	5' - 0" 3' - 0"	1' - 9 1/8" 1' - 9 1/8"	2' - 11 1/4" 2' - 11 1/4"	1 PT-4 LOCK 1 PT-4 LOCK	DOOR & FRAME TYPES	KIN
4 5	303J432LFlush Overlay Steel E306J8320Flush Overlay Steel E		2' - 0" 4' - 0"	1' - 9 1/8" 1' - 9 1/8"	2' - 11 1/4" 2' - 11 1/4"	1 PT-4 LOCK 1 PT-4	$\frac{8}{1/2"} = 1' - 0"$	1 VA
6	341J432LFlush Overlay Steel E525J3680Flush Overlay Steel E	ase Cabinet	2' - 0" 7/8"	1' - 9 1/8" 2' - 4 7/8"	2' - 11 1/4" 2' - 11 1/4"	1 PT-4 LOCK 1 PT-4	0 6" 1'	
1	806J792L Flush Overlay Steel T	all Cabinet	3' - 6"	1' - 10"	7' - 0 5/8"	1 PT-4 LOCK	→ VARIES, VIF (7 5/8" ASSUMED) A SAW CUT THE BRICK TO	
2 1	806J892LFlush Overlay Steel TFO SteelFlush Overlay Steel K	all Cabinet neespace Panel and Rails	4' - 0"	1' - 10" 1' - 9 1/8"	7' - 0 5/8" 2' - 11 1/4"	2 PT-4 LOCK 2 PT-4	ACCOMMODATE METAL ANGLE FLANGES.	1/2"
1	Kneespace522J3610Leg Assembly			1' - 9 5/8"	2' - 11 1/4"	1 PT-4	EXISTING GLAZED FACING	
1	52L80500 Glassware Pegboard		1' - 6"	1" 2"	2' - 0" 2' - 11 1/4"	1 PT-4 6 PT-4	ANGLE LINTEL, EXTEND TILE WALL, SAW CUT OPENING TYP. DO NOT OVER CUT.	~
-1 :-1	702J423L Flush Overlay Steel V	/all Cabinet	2' - 0"	2 1' - 1"	2' - 1 1/4"	1 PT-4 LOCK	SEALANT, BOTH SIDES TYP.	
-2 -3	703J423L Flush Overlay Steel V 706J523L Flush Overlay Steel V		2' - 0" 2' - 6"	1' - 1" 1' - 1"	2' - 1 1/4" 2' - 1 1/4"	1 PT-4 LOCK 4 PT-4	GROUT HEAD	
-4 -5	706J623LFlush Overlay Steel V706J823LFlush Overlay Steel V		3' - 0" 4' - 0"	1' - 1" 1' - 1"	2' - 1 1/4" 2' - 1 1/4"	3 PT-4 LOCK 1 PT-4 LOCK	HM FRAME	
	IS OF DESIGN: THERMO FISHER SCIENT				2 1 1/1		SCHEDULED DOOR	DOC
			0				WELD 5/16" THICK METAL PLATE TO THE ANGLE LINTEL	3" = 1
EQUIPMEN	NT	EQUIPMENT SCHEDULE -	SEE ALSO SF	PECIFICATION SEC	CTION 11 00 00			
Equipmen Number		EQUIPMENT SCHEDULE - MANUFACTURER		PECIFICATION SEC POWER REQ F		COMMENTS		SEMBLY. REFE
NUMBER EQ-100	R DESCRIPTION Fish tank system (Z-Hib Mini)	MANUFACTURER Aquatic Habitat, Benchtop	ROOM 333	POWER REQ F 120V -10.5A	PROVIDED BY OFOI	COMMENTS (Owner filter). Future installation		SEMBLY. REFE FRAME STAGGER SCRE EACH ST
NUMBER EQ-100 EQ-200 EQ-201	R DESCRIPTION Fish tank system (Z-Hib Mini) Bedding station Animal cage racks	MANUFACTURER Aquatic Habitat, Benchtop Techiplast, DS36 TBD	ROOM 333 335 335	POWER REQ F 120V -10.5A 115V - 8.6 A NA	OFOI CFCI OFCI	COMMENTS	DOOR HEAD DETAIL - EXISTING WALL	SEMBLY. REFE FRAME STAGGER SCRE EACH ST
NUMBER EQ-100 EQ-200 EQ-201 EQ-202	RDESCRIPTIONFish tank system (Z-Hib Mini)Bedding stationAnimal cage racksMobile Computer Station	MANUFACTURER Aquatic Habitat, Benchtop Techiplast, DS36	ROOM 333 335	POWER REQ F 120V -10.5A 115V - 8.6 A	PROVIDED BY OFOI CFCI	COMMENTS (Owner filter). Future installation Exhaust and air filter in the equipment	DOOR HEAD DETAIL - EXISTING WALL	SEMBLY. REFE FRAME STAGGER SCRE EACH ST
NUMBER EQ-100 EQ-200 EQ-201 EQ-202 XEQ-001 XEQ-002	RDESCRIPTIONPFish tank system (Z-Hib Mini)PBedding stationAnimal cage racksAnimal cage racksMobile Computer Station1Tool box2Cyro	MANUFACTURER Aquatic Habitat, Benchtop Techiplast, DS36 TBD TBD Existing Existing Existing	ROOM 333 335 335 335 327 327	POWER REQ F 120V -10.5A 1 115V - 8.6 A 1 NA 1 NA 1 NA 1 - 1	OFOI CFCI OFCI OFCI OFCI OFCI OFCI	COMMENTS (Owner filter). Future installation Exhaust and air filter in the equipment Quantity 2	5 DOOR HEAD DETAIL - EXISTING WALL AS 3" = 1'-0" ADJ. WALL	SEMBLY. REFE FRAME STAGGER SCRE EACH ST
NUMBER EQ-100 EQ-200 EQ-201 EQ-202 XEQ-001 XEQ-002 XEQ-003 XEQ-004	RDESCRIPTIONPFish tank system (Z-Hib Mini)PBedding stationAnimal cage racksAnimal cage racksMobile Computer Station1Tool box2Cyro3Faraday box4Faraday box	MANUFACTURER Aquatic Habitat, Benchtop Techiplast, DS36 TBD TBD Existing Existing Existing Existing Existing Existing Existing	ROOM 333 335 335 335 327	POWER REQ F 120V -10.5A 1 115V - 8.6 A 1 NA 1 NA 1 NA 1 NA 1 NA 1 NA 1 NA 1	PROVIDED BY OFOI CFCI OFCI OFCI OFCI OFCI OFCI OFCI	COMMENTS (Owner filter). Future installation Exhaust and air filter in the equipment Quantity 2 With operable lid	$5 \frac{\text{DOOR HEAD DETAIL - EXISTING WALL}}{3" = 1'-0"} $	SEMBLY. REFE FRAME STAGGER SCRE EACH ST
NUMBER EQ-100 EQ-200 EQ-201 EQ-202 XEQ-001 XEQ-002 XEQ-003 XEQ-004 XEQ-005	RDESCRIPTIONPFish tank system (Z-Hib Mini)PBedding stationAnimal cage racksAnimal cage racksMobile Computer Station1Tool box2Cyro3Faraday box4Faraday box5Table	MANUFACTURER Aquatic Habitat, Benchtop Techiplast, DS36 TBD TBD Existing Existing Existing Existing Existing Existing Existing Existing Existing	ROOM 333 335 335 327 327 327 327 327 327	POWER REQ F 120V -10.5A 1 115V - 8.6 A 1 NA 1 NA 1 NA 1 NA 1 NA 1 NA 1 NA 1 NA 1 NA 1	PROVIDED BY OFOI CFCI OFCI OFOI OFCI OFCI OFCI	COMMENTS (Owner filter). Future installation Exhaust and air filter in the equipment Quantity 2 With operable lid	5 DOOR HEAD DETAIL - EXISTING WALL 3" = 1'-0" ADJ. WALL EXISTING STRUCTURAL	SEMBLY. REFE FRAME STAGGER SCRE EACH ST VERT VERT
EQ-100 EQ-200 EQ-201 EQ-202 XEQ-001 XEQ-002 XEQ-003 XEQ-004 XEQ-005 XEQ-006 XEQ-100	RDESCRIPTIONPFish tank system (Z-Hib Mini)PBedding stationAnimal cage racksAnimal cage racksMobile Computer Station1Tool box2Cyro3Faraday box4Faraday box5Table6Full-height cabinet0Digital Scale 1	MANUFACTURERAquatic Habitat, BenchtopTechiplast, DS36TBDTBDExisting	ROOM 333 335 335 335 327	POWER REQ F 120V -10.5A 1 115V - 8.6 A 1 NA 1	PROVIDED BY OFOI CFCI OFCI OFCI OFCI OFCI OFCI OFCI	COMMENTS (Owner filter). Future installation Exhaust and air filter in the equipment Quantity 2 With operable lid Open RHS On countertop, new location	5 DOOR HEAD DETAIL - EXISTING WALL 3" = 1'-0" ADJ. WALL EXISTING STRUCTURAL	SEMBLY. REFE FRAME STAGGER SCRI EACH ST VERT ("8/L f) JIN 'SJINA SEALAN'
EQ-100 EQ-200 EQ-201 EQ-202 XEQ-001 XEQ-003 XEQ-004 XEQ-005 XEQ-006 XEQ-100 XEQ-100	RDESCRIPTIONPFish tank system (Z-Hib Mini)PBedding stationAnimal cage racksAnimal cage racksMobile Computer Station1Tool box2Cyro3Faraday box4Faraday box5Table6Full-height cabinet0Digital Scale 11Digital scale 2	MANUFACTURER Aquatic Habitat, Benchtop Techiplast, DS36 TBD Existing	ROOM 333 335 335 327 327 327 327 327 327 327 327	POWER REQ F 120V -10.5A 1 115V - 8.6 A 1 NA 1	PROVIDED BY OFOI CFCI OFCI OFCI OFCI OFCI OFCI OFCI	COMMENTS (Owner filter). Future installation Exhaust and air filter in the equipment Quantity 2 With operable lid Open RHS	5 DOOR HEAD DETAIL - EXISTING WALL 3" = 1'-0"	SEMBLY. REFE FRAME STAGGER SCRI EACH ST VERT VERT (18) VERT VERT SEALAN
EQ-100 EQ-200 EQ-201 EQ-202 XEQ-001 XEQ-003 XEQ-004 XEQ-005 XEQ-100 XEQ-100 XEQ-100 XEQ-100 XEQ-101 XEQ-102 XEQ-103 XEQ-104 XEQ-105 XEQ-101 XEQ-102 XEQ-103	RDESCRIPTION0Fish tank system (Z-Hib Mini)0Bedding station1Animal cage racks1Mobile Computer Station1Tool box2Cyro3Faraday box4Faraday box5Table6Full-height cabinet0Digital Scale 11Digital scale 22Sonic cleaner3PH meter	MANUFACTURERAquatic Habitat, BenchtopTechiplast, DS36TBDTBDExisting	ROOM 333 335 335 335 327 327 327 327 327 327 327 327 327 327 327 323 333 333 333 333 333	POWER REQ F 120V -10.5A 1 115V - 8.6 A 1 NA 1 120V 1 120V 1 120V 1	PROVIDED BY OFOI CFCI OFCI OFCI OFCI OFCI OFCI OFCI	COMMENTS (Owner filter). Future installation Exhaust and air filter in the equipment Quantity 2 With operable lid Open RHS On countertop, new location	5 DOOR HEAD DETAIL - EXISTING WALL 3" = 1'-0"	SEMBLY. REFE FRAME STAGGER SCRE EACH ST VERT (18/1 / 19/1 VERT VERT SEALAN
NUMBER EQ-100 EQ-200 EQ-201 EQ-202 XEQ-001 XEQ-003 XEQ-004 XEQ-005 XEQ-006 XEQ-100 XEQ-100 XEQ-101 XEQ-102 XEQ-103 XEQ-104 XEQ-105	RDESCRIPTIONPFish tank system (Z-Hib Mini)PBedding stationAnimal cage racksMobile Computer Station1Tool box2Cyro3Faraday box4Faraday box5Table6Full-height cabinet0Digital Scale 11Digital scale 22Sonic cleaner3PH meter4Side warmer5Flammable storage	MANUFACTURERAquatic Habitat, BenchtopTechiplast, DS36TBDTBDExisting	ROOM 333 335 335 335 335 327 327 327 327 327 327 327 327 327 323 333 333 333 333 333 333 333 333 333 333	POWER REQ F 120V -10.5A 1 115V - 8.6 A 1 NA 1 120V 1 120V 1 120V 1 NA 1	PROVIDED BY OFOI CFCI OFCI OFCI OFCI OFCI OFCI OFCI	COMMENTS (Owner filter). Future installation Exhaust and air filter in the equipment Quantity 2 With operable lid Open RHS On countertop, new location Yellow box, below countertop	5 DOOR HEAD DETAIL - EXISTING WALL 3" = 1'-0"	SEMBLY. REFE FRAME STAGGER SCRE EACH ST VERT (
NUMBER EQ-100 EQ-200 EQ-201 EQ-202 XEQ-001 XEQ-002 XEQ-003 XEQ-004 XEQ-005 XEQ-006 XEQ-100 XEQ-100 XEQ-101 XEQ-102 XEQ-103 XEQ-104 XEQ-105	RDESCRIPTION0Fish tank system (Z-Hib Mini)0Bedding station1Animal cage racks1Mobile Computer Station1Tool box2Cyro3Faraday box4Faraday box5Table6Full-height cabinet0Digital Scale 11Digital scale 22Sonic cleaner3PH meter4Side warmer5Flammable storage6Acid storage	MANUFACTURERAquatic Habitat, BenchtopTechiplast, DS36TBDTBDExisting	ROOM 333 335 335 335 327 327 327 327 327 327 327 327 327 327 323 333 333 333 333 333 333 333	POWER REQ F 120V -10.5A 1 115V - 8.6 A 1 NA 1 120V 1 120V 1 120V 1 120V 1 120V 1	PROVIDED BY OFOI CFCI OFCI OFCI OFCI OFCI OFCI OFCI	COMMENTS (Owner filter). Future installation Exhaust and air filter in the equipment Quantity 2 With operable lid Open RHS On countertop, new location	5 DOOR HEAD DETAIL - EXISTING WALL 3" = 1'-0"	SEMBLY. REFE FRAME STAGGER SCRE EACH ST VERTI (18/L f) JIN 'SJ NV SEALANT
NUMBER EQ-100 EQ-200 EQ-201 EQ-202 XEQ-001 XEQ-002 XEQ-003 XEQ-004 XEQ-005 XEQ-006 XEQ-100 XEQ-100 XEQ-100 XEQ-102 XEQ-103 XEQ-104 XEQ-105 XEQ-106 XEQ-107 XEQ-108	RDESCRIPTIONPFish tank system (Z-Hib Mini)PBedding stationAnimal cage racksMobile Computer Station1Tool box2Cyro3Faraday box4Faraday box5Table6Full-height cabinet0Digital Scale 11Digital scale 22Sonic cleaner3PH meter4Side warmer5Flammable storage6Acid storage7Refrigerator8Racks	MANUFACTURERAquatic Habitat, BenchtopTechiplast, DS36TBDTBDExisting	ROOM 333 335 335 335 335 327 327 327 327 327 327 327 327 323 333	POWER REQ F 120V -10.5A 1 115V - 8.6 A 1 NA 1 120V 1 120V 1 120V 1 NA 1	PROVIDED BY OFOI CFCI OFCI OFCI OFCI OFCI OFCI OFCI	COMMENTS (Owner filter). Future installation Exhaust and air filter in the equipment Quantity 2 With operable lid Open RHS On countertop, new location Ou countertop Blue box, below countertop Blue box, below countertop Quantity 2	5 DOOR HEAD DETAIL - EXISTING WALL 3" = 1'-0"	SEMBLY. REFEI FRAME STAGGER SCRE EACH STI VERTI (18/L F) JIN 'S SEALANT
NUMBER EQ-100 EQ-200 EQ-201 EQ-202 XEQ-003 XEQ-003 XEQ-004 XEQ-005 XEQ-006 XEQ-100 XEQ-100 XEQ-101 XEQ-102 XEQ-103 XEQ-104 XEQ-106 XEQ-107 XEQ-108 XEQ-109 XEQ-200	RDESCRIPTIONFish tank system (Z-Hib Mini)Bedding stationAnimal cage racksMobile Computer Station1Tool box2Cyro3Faraday box4Faraday box5Table6Full-height cabinet0Digital Scale 111Digital scale 22Sonic cleaner3PH meter4Side warmer55Flammable storage6Acid storage7Refrigerator8Racks9Tank0Digital scale	MANUFACTURERAquatic Habitat, BenchtopTechiplast, DS36TBDTBDExisting	ROOM 333 335 335 335 335 327 327 327 327 327 327 327 327 323 333	POWER REQ F 120V -10.5A 1 115V - 8.6 A 1 NA 1 120V 1 120V 1 120V 1 NA 1	OFOI OFOI CFCI OFOI OFCI OFCI <t< td=""><td>COMMENTS (Owner filter). Future installation Exhaust and air filter in the equipment Quantity 2 With operable lid Open RHS On countertop, new location Ou countertop, new location Ou countertop, new location Ou countertop, new location Outertop, new location Outertop Blue box, below countertop Blue box, below countertop Quantity 10, filter and heater in each tank</td><td>5 DOOR HEAD DETAIL - EXISTING WALL 3" = 1'-0"</td><td>SEMBLY. REFEI FRAME STAGGER SCRE EACH STI VERTI (18/L P) JIN 'S SEALANT</td></t<>	COMMENTS (Owner filter). Future installation Exhaust and air filter in the equipment Quantity 2 With operable lid Open RHS On countertop, new location Ou countertop, new location Ou countertop, new location Ou countertop, new location Outertop, new location Outertop Blue box, below countertop Blue box, below countertop Quantity 10, filter and heater in each tank	5 DOOR HEAD DETAIL - EXISTING WALL 3" = 1'-0"	SEMBLY. REFEI FRAME STAGGER SCRE EACH STI VERTI (18/L P) JIN 'S SEALANT
NUMBER EQ-100 EQ-200 EQ-201 EQ-202 XEQ-001 XEQ-002 XEQ-003 XEQ-004 XEQ-005 XEQ-006 XEQ-100 XEQ-101 XEQ-102 XEQ-103 XEQ-104 XEQ-103 XEQ-104 XEQ-105 XEQ-104 XEQ-105 XEQ-107 XEQ-108 XEQ-109 XEQ-200 XEQ-201	RDESCRIPTIONFish tank system (Z-Hib Mini)Bedding stationAnimal cage racksMobile Computer Station1Tool box2Cyro3Faraday box4Faraday box5Table6Full-height cabinet0Digital Scale 111Digital scale 22Sonic cleaner3PH meter4Side warmer5Flammable storage6Acid storage7Refrigerator8Racks9Tank0Digital scale1Circadian box 1	MANUFACTURERAquatic Habitat, BenchtopTechiplast, DS36TBDTBDExisting	ROOM 333 335 335 335 335 327 327 327 327 327 327 323 333	POWER REQ F 120V -10.5A 1 115V - 8.6 A 1 NA 1 120V 1 120V 1 120V 1 NA 1 NA 1 NA 1 120V 1 NA 1	OFOI OFOI OFCI OFCI <t< td=""><td>COMMENTS (Owner filter). Future installation Exhaust and air filter in the equipment Quantity 2 With operable lid Open RHS On countertop, new location Outertop, new location Outertop, new location Quantity 2 Quantity 10, filter and heater in each tank Cabinet has built-in exhaust but needs to have some clearance to accommodate the internal exhaust</td><td>5 DOOR HEAD DETAIL - EXISTING WALL 3" = 1'-0"</td><td>SEMBLY. REFEI FRAME STAGGER SCRE EACH STI VERTI (8/L P) JIN 'S SEALANT</td></t<>	COMMENTS (Owner filter). Future installation Exhaust and air filter in the equipment Quantity 2 With operable lid Open RHS On countertop, new location Outertop, new location Outertop, new location Quantity 2 Quantity 10, filter and heater in each tank Cabinet has built-in exhaust but needs to have some clearance to accommodate the internal exhaust	5 DOOR HEAD DETAIL - EXISTING WALL 3" = 1'-0"	SEMBLY. REFEI FRAME STAGGER SCRE EACH STI VERTI (8/L P) JIN 'S SEALANT
NUMBER EQ-100 EQ-200 EQ-201 EQ-202 XEQ-001 XEQ-003 XEQ-004 XEQ-005 XEQ-006 XEQ-100 XEQ-101 XEQ-102 XEQ-103 XEQ-104 XEQ-103 XEQ-104 XEQ-105 XEQ-104 XEQ-105 XEQ-107 XEQ-107 XEQ-108 XEQ-109 XEQ-200	RDESCRIPTIONFish tank system (Z-Hib Mini)Bedding stationAnimal cage racksMobile Computer Station1Tool box2Cyro3Faraday box4Faraday box5Table6Full-height cabinet0Digital Scale 111Digital scale 22Sonic cleaner3PH meter4Side warmer5Flammable storage6Acid storage7Refrigerator8Racks9Tank0Digital scale1Circadian box 1	MANUFACTURERAquatic Habitat, BenchtopTechiplast, DS36TBDTBDExisting	ROOM 333 335 335 335 335 327 327 327 327 327 327 327 327 323 333	POWER REQ F 120V -10.5A 1 115V - 8.6 A 1 NA 1 120V 1 120V 1 120V 1 NA 1	OFOI OFOI CFCI OFOI OFCI OFCI <t< td=""><td>COMMENTS (Owner filter). Future installation Exhaust and air filter in the equipment Quantity 2 With operable lid Open RHS On countertop, new location Ou countertop, new location Outertop Blue box, below countertop Blue box, below countertop Quantity 2 Quantity 10, filter and heater in each tank Cabinet has built-in exhaust but needs to have some</td><td>5 DOOR HEAD DETAIL - EXISTING WALL 3" = 1'-0"</td><td>SEMBLY. REFEI FRAME STAGGER SCRE EACH STI VERTI (18/L F) JIN 'S SEALANT</td></t<>	COMMENTS (Owner filter). Future installation Exhaust and air filter in the equipment Quantity 2 With operable lid Open RHS On countertop, new location Ou countertop, new location Outertop Blue box, below countertop Blue box, below countertop Quantity 2 Quantity 10, filter and heater in each tank Cabinet has built-in exhaust but needs to have some	5 DOOR HEAD DETAIL - EXISTING WALL 3" = 1'-0"	SEMBLY. REFEI FRAME STAGGER SCRE EACH STI VERTI (18/L F) JIN 'S SEALANT
NUMBER EQ-100 EQ-200 EQ-201 EQ-202 XEQ-001 XEQ-002 XEQ-003 XEQ-004 XEQ-005 XEQ-006 XEQ-100 XEQ-100 XEQ-101 XEQ-102 XEQ-103 XEQ-104 XEQ-105 XEQ-104 XEQ-105 XEQ-104 XEQ-105 XEQ-106 XEQ-107 XEQ-108 XEQ-109 XEQ-200 XEQ-201 XEQ-202 XEQ-204	RDESCRIPTION0Fish tank system (Z-Hib Mini)0Bedding station1Animal cage racks1Mobile Computer Station1Tool box2Cyro3Faraday box4Faraday box5Table6Full-height cabinet0Digital Scale 11Digital scale 22Sonic cleaner3PH meter4Side warmer5Flammable storage6Acid storage7Refrigerator8Racks9Tank0Digital scale 11Circadian box 12Circadian box 24Desktop computer	MANUFACTURERAquatic Habitat, BenchtopTechiplast, DS36TBDTBDExisting	ROOM 333 335 335 335 327 327 327 327 327 327 327 323 333	POWER REQ F 120V -10.5A 1 115V - 8.6 A 1 NA 1 120V 1 120V 1 120V 1 NA 1	OFOI OFOI CFCI OFOI OFCI OFCI <t< td=""><td>COMMENTS (Owner filter). Future installation Exhaust and air filter in the equipment Quantity 2 With operable lid Open RHS On countertop, new location Quantity 0, filter and heater in each tank Quantity 10, filter and heater in each tank Cabinet has built-in exhaust but needs to have some clearance to accommodate the internal exhaust Cabinet has built-in exhaust but needs to have some clearance to accommodate the internal exhaust Quantity 2</td><td>5 DOOR HEAD DETAIL - EXISTING WALL 3" = 1'-0"</td><td>SEMBLY. REFE FRAME STAGGER SCRE EACH ST VERTI (18/L f) JIN 'S SEALANT</td></t<>	COMMENTS (Owner filter). Future installation Exhaust and air filter in the equipment Quantity 2 With operable lid Open RHS On countertop, new location Quantity 0, filter and heater in each tank Quantity 10, filter and heater in each tank Cabinet has built-in exhaust but needs to have some clearance to accommodate the internal exhaust Cabinet has built-in exhaust but needs to have some clearance to accommodate the internal exhaust Quantity 2	5 DOOR HEAD DETAIL - EXISTING WALL 3" = 1'-0"	SEMBLY. REFE FRAME STAGGER SCRE EACH ST VERTI (18/L f) JIN 'S SEALANT
NUMBER EQ-100 EQ-200 EQ-201 EQ-202 XEQ-001 XEQ-002 XEQ-003 XEQ-004 XEQ-005 XEQ-006 XEQ-100 XEQ-101 XEQ-102 XEQ-103 XEQ-104 XEQ-105 XEQ-107 XEQ-108 XEQ-107 XEQ-108 XEQ-109 XEQ-200 XEQ-200 XEQ-201 XEQ-202 XEQ-203 XEQ-204 XEQ-205 XEQ-206	RDESCRIPTIONFish tank system (Z-Hib Mini)Bedding stationAnimal cage racksMobile Computer Station1Tool box2Cyro3Faraday box4Faraday box5Table6Full-height cabinet0Digital Scale 11Digital Scale 22Sonic cleaner3PH meter4Side warmer5Flammable storage6Acid storage7Refrigerator8Racks910Digital scale11Circadian box 12Circadian box 24Desktop computer56Bedding bin	MANUFACTURERAquatic Habitat, BenchtopTechiplast, DS36TBDTBDExisting<	ROOM 333 335 335 335 335 327 327 327 327 327 327 323 333	POWER REQ F 120V -10.5A 1 115V - 8.6 A 1 NA 1 120V 1 120V 1 120V 1 NA 1 NA 1 NA 1 120V 1 NA 1 120V 1 120V 1 NA 1 NA 1 NA 1 NA 1 NA 1 <td>PROVIDED BY OFOI CFCI OFOI OFCI OFCI</td> <td>COMMENTS (Owner filter). Future installation Exhaust and air filter in the equipment Quantity 2 With operable lid Open RHS On countertop, new location Ou countertop, new location Outer top, new location Quantity 2 Quantity 10, filter and heater in each tank Cabinet has built-in exhaust but needs to have some clearance to accommodate the internal exhaust Cabinet has built-in exhaust but needs to have some clearance to accommodate the internal exhaust</td> <td>5 DOOR HEAD DETAIL - EXISTING WALL 3" = 1'-0"</td> <td>SEMBLY. REFE FRAME STAGGER SCRE EACH ST VERTI (18/L f) JIN 'SJ NV SEALANT</td>	PROVIDED BY OFOI CFCI OFOI OFCI	COMMENTS (Owner filter). Future installation Exhaust and air filter in the equipment Quantity 2 With operable lid Open RHS On countertop, new location Ou countertop, new location Outer top, new location Quantity 2 Quantity 10, filter and heater in each tank Cabinet has built-in exhaust but needs to have some clearance to accommodate the internal exhaust Cabinet has built-in exhaust but needs to have some clearance to accommodate the internal exhaust	5 DOOR HEAD DETAIL - EXISTING WALL 3" = 1'-0"	SEMBLY. REFE FRAME STAGGER SCRE EACH ST VERTI (18/L f) JIN 'SJ NV SEALANT
NUMBER EQ-100 EQ-200 EQ-201 EQ-202 XEQ-001 XEQ-002 XEQ-003 XEQ-004 XEQ-005 XEQ-006 XEQ-100 XEQ-101 XEQ-102 XEQ-103 XEQ-104 XEQ-105 XEQ-104 XEQ-105 XEQ-106 XEQ-107 XEQ-108 XEQ-109 XEQ-200 XEQ-201 XEQ-202 XEQ-203 XEQ-204 XEQ-205 XEQ-206 XEQ-207	RDESCRIPTIONFish tank system (Z-Hib Mini)Bedding stationAnimal cage racksMobile Computer Station1Tool box2Cyro3Faraday box4Faraday box5Table6Full-height cabinet00Digital Scale 1111Digital scale 22Sonic cleaner3PH meter4Side warmer5Flammable storage6Acid storage7Refrigerator8911Digital scale12Circadian box 122Circadian box 24Desktop computer5566677	MANUFACTURERAquatic Habitat, BenchtopTechiplast, DS36TBDTBDExisting<	ROOM 333 335 335 335 335 327 327 327 327 327 327 323 333	POWER REQ F 120V -10.5A I 115V - 8.6 A I NA I 120V I 120V I NA I I20V I	OFOI OFOI CFCI OFCI OFCI <t< td=""><td>COMMENTS (Owner filter). Future installation Exhaust and air filter in the equipment Quantity 2 With operable lid Open RHS On countertop, new location Ou countertop, new location On countertop, new location Quantity 10, filter and heater in each tank Quantity 2 Quantity 10, filter and heater in each tank Cabinet has built-in exhaust but needs to have some clearance to accommodate the internal exhaust Cabinet has built-in exhaust but needs to have some clearance to accommodate the internal exhaust Quantity 2 Quantity 2 Quantity 2 Quantity 2</td><td>(2) DOOR HEAD DETAIL - EXISTING WALL 3" = 1'-0" DOOR HEAD DETAIL - EXISTING WALL WALL EXISTING STRUCTURAL COUNTERSUM FLATHED SOLID, TP FRAME ANCHOR SOLID, TP</td><td>SEMBLY. REFEF FRAME STAGGER SCREY EACH STI VERTIN SEALANT DOO 3" = 1</td></t<>	COMMENTS (Owner filter). Future installation Exhaust and air filter in the equipment Quantity 2 With operable lid Open RHS On countertop, new location Ou countertop, new location On countertop, new location Quantity 10, filter and heater in each tank Quantity 2 Quantity 10, filter and heater in each tank Cabinet has built-in exhaust but needs to have some clearance to accommodate the internal exhaust Cabinet has built-in exhaust but needs to have some clearance to accommodate the internal exhaust Quantity 2 Quantity 2 Quantity 2 Quantity 2	(2) DOOR HEAD DETAIL - EXISTING WALL 3" = 1'-0" DOOR HEAD DETAIL - EXISTING WALL WALL EXISTING STRUCTURAL COUNTERSUM FLATHED SOLID, TP FRAME ANCHOR SOLID, TP	SEMBLY. REFEF FRAME STAGGER SCREY EACH STI VERTIN SEALANT DOO 3" = 1
EQ-100 EQ-200 EQ-201 EQ-202 XEQ-001 XEQ-002 XEQ-003 XEQ-004 XEQ-006 XEQ-100 XEQ-100 XEQ-101 XEQ-102 XEQ-103 XEQ-104 XEQ-103 XEQ-104 XEQ-107 XEQ-106 XEQ-107 XEQ-108 XEQ-107 XEQ-108 XEQ-200 XEQ-200 XEQ-201 XEQ-202	RDESCRIPTION0Fish tank system (Z-Hib Mini)0Bedding station1Animal cage racks1Mobile Computer Station1Tool box2Cyro3Faraday box4Faraday box5Table6Full-height cabinet0Digital Scale 11Digital scale 22Sonic cleaner3PH meter4Side warmer5Flammable storage6Acid storage7Refrigerator8Racks9Tank0Digital scale 11Circadian box 12Circadian box 24Desktop computer5Bedding bin7Food hopper8Morris water maze9Cage rack	MANUFACTURERAquatic Habitat, BenchtopTechiplast, DS36TBDTBDExisting<	ROOM 333 335 335 335 335 327 327 327 327 327 327 323 333	POWER REQ F 120V -10.5A 1 115V - 8.6 A 1 NA 1 120V 1 120V 1 120V 1 NA 1 NA 1 NA 1 120V 1 NA 1 120V 1 120V 1 NA 1 NA 1 NA 1 NA 1 NA 1 <td>PROVIDED BY OFOI CFCI OFOI OFCI OFCI</td> <td>COMMENTS (Owner filter). Future installation Exhaust and air filter in the equipment Quantity 2 With operable lid Open RHS On countertop, new location Quantity 0, filter and heater in each tank Quantity 10, filter and heater in each tank Cabinet has built-in exhaust but needs to have some clearance to accommodate the internal exhaust Cabinet has built-in exhaust but needs to have some clearance to accommodate the internal exhaust Quantity 2</td> <td>(2) DOOR HEAD DETAIL - EXISTING WALL 3" = 1'-0" DOOR HEAD DETAIL - EXISTING WALL WALL EXISTING STRUCTURAL COUNTERSUM FLATHED SOLID, TP FRAME ANCHOR SOLID, TP</td> <td>20 GA DOUBLE SEMBLY. REFER FRAME TAGGER SCREW EACH STIL VERTIN SEALANT DOO 3" = 1</td>	PROVIDED BY OFOI CFCI OFOI OFCI	COMMENTS (Owner filter). Future installation Exhaust and air filter in the equipment Quantity 2 With operable lid Open RHS On countertop, new location Quantity 0, filter and heater in each tank Quantity 10, filter and heater in each tank Cabinet has built-in exhaust but needs to have some clearance to accommodate the internal exhaust Cabinet has built-in exhaust but needs to have some clearance to accommodate the internal exhaust Quantity 2	(2) DOOR HEAD DETAIL - EXISTING WALL 3" = 1'-0" DOOR HEAD DETAIL - EXISTING WALL WALL EXISTING STRUCTURAL COUNTERSUM FLATHED SOLID, TP FRAME ANCHOR SOLID, TP	20 GA DOUBLE SEMBLY. REFER FRAME TAGGER SCREW EACH STIL VERTIN SEALANT DOO 3" = 1

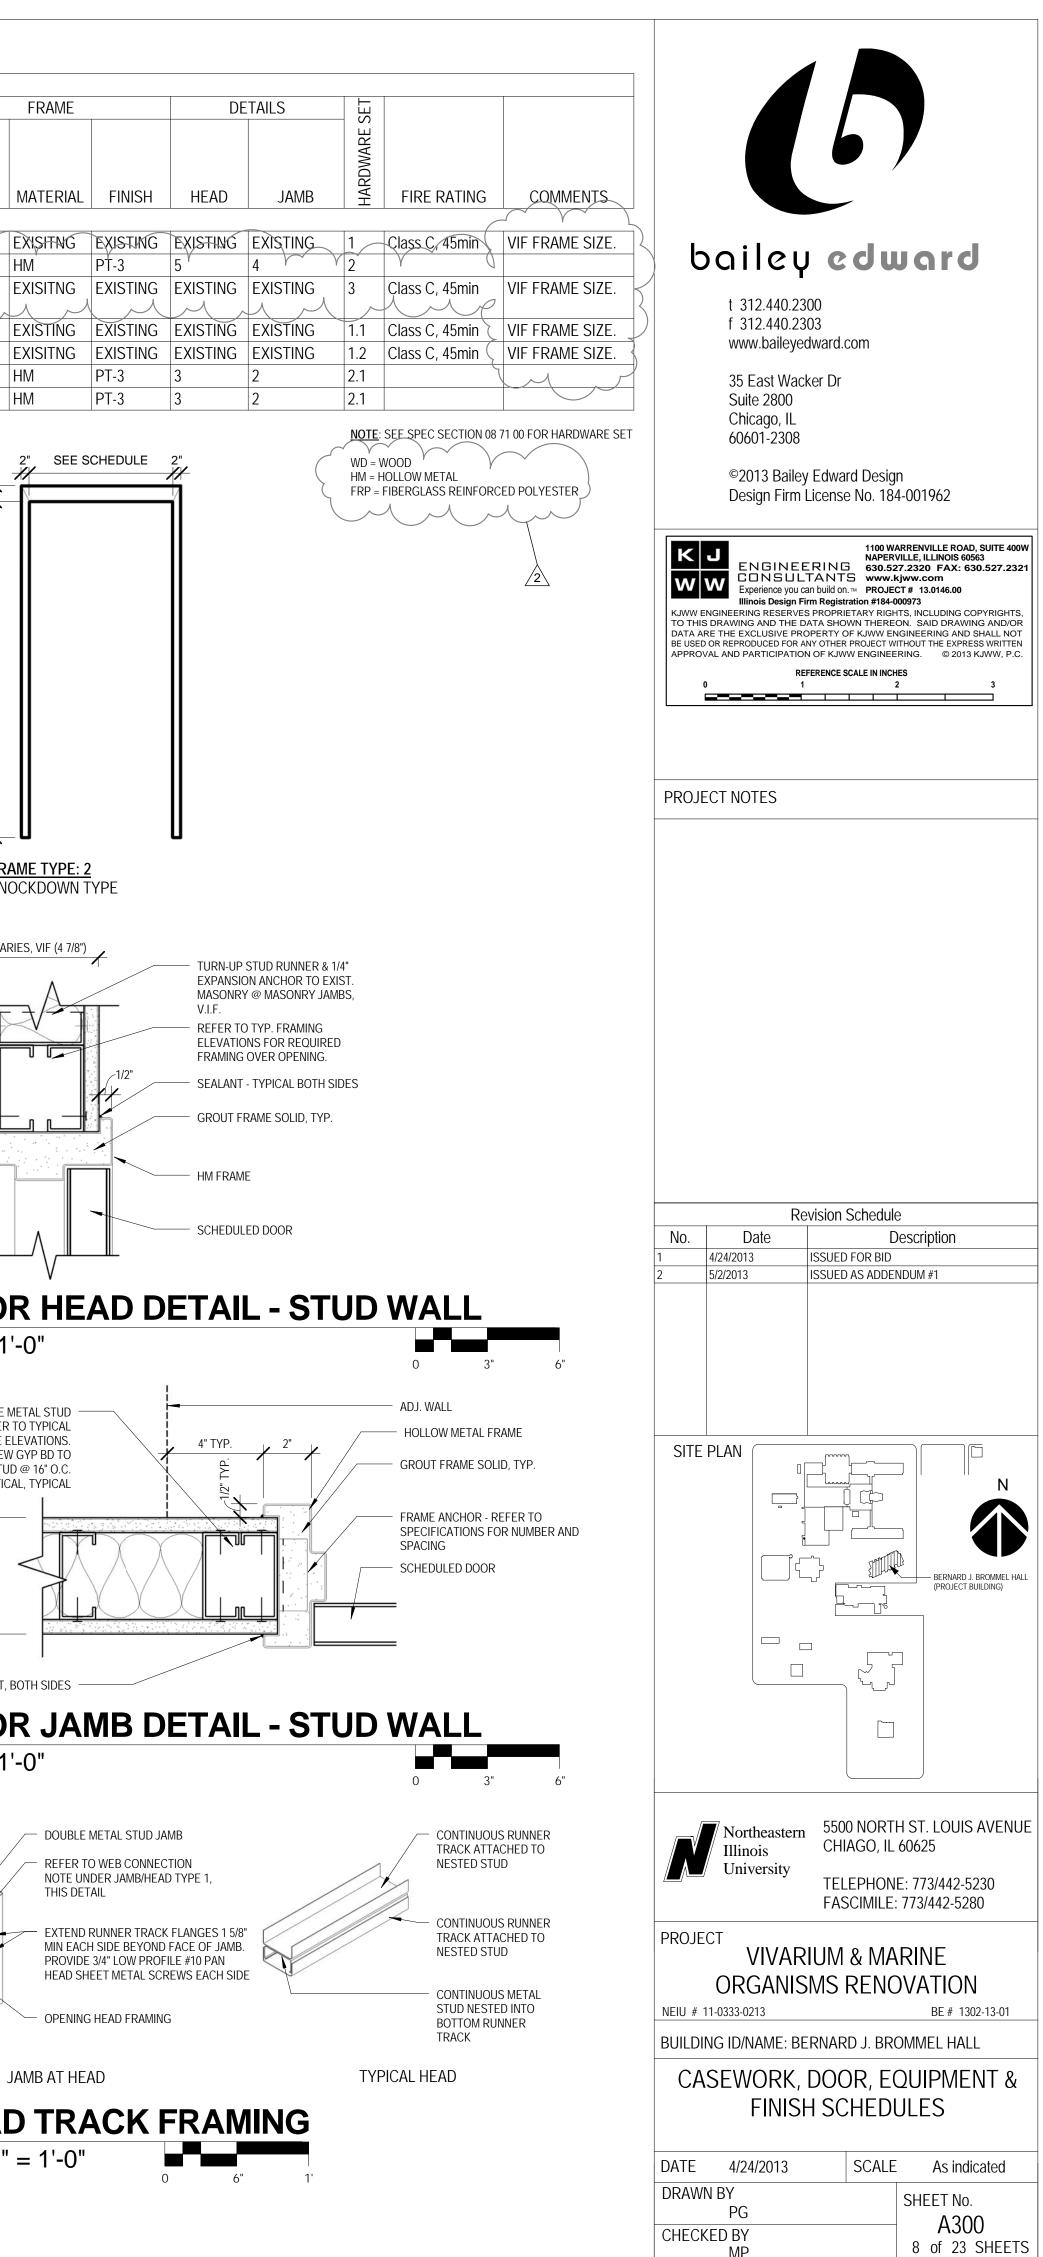

MP

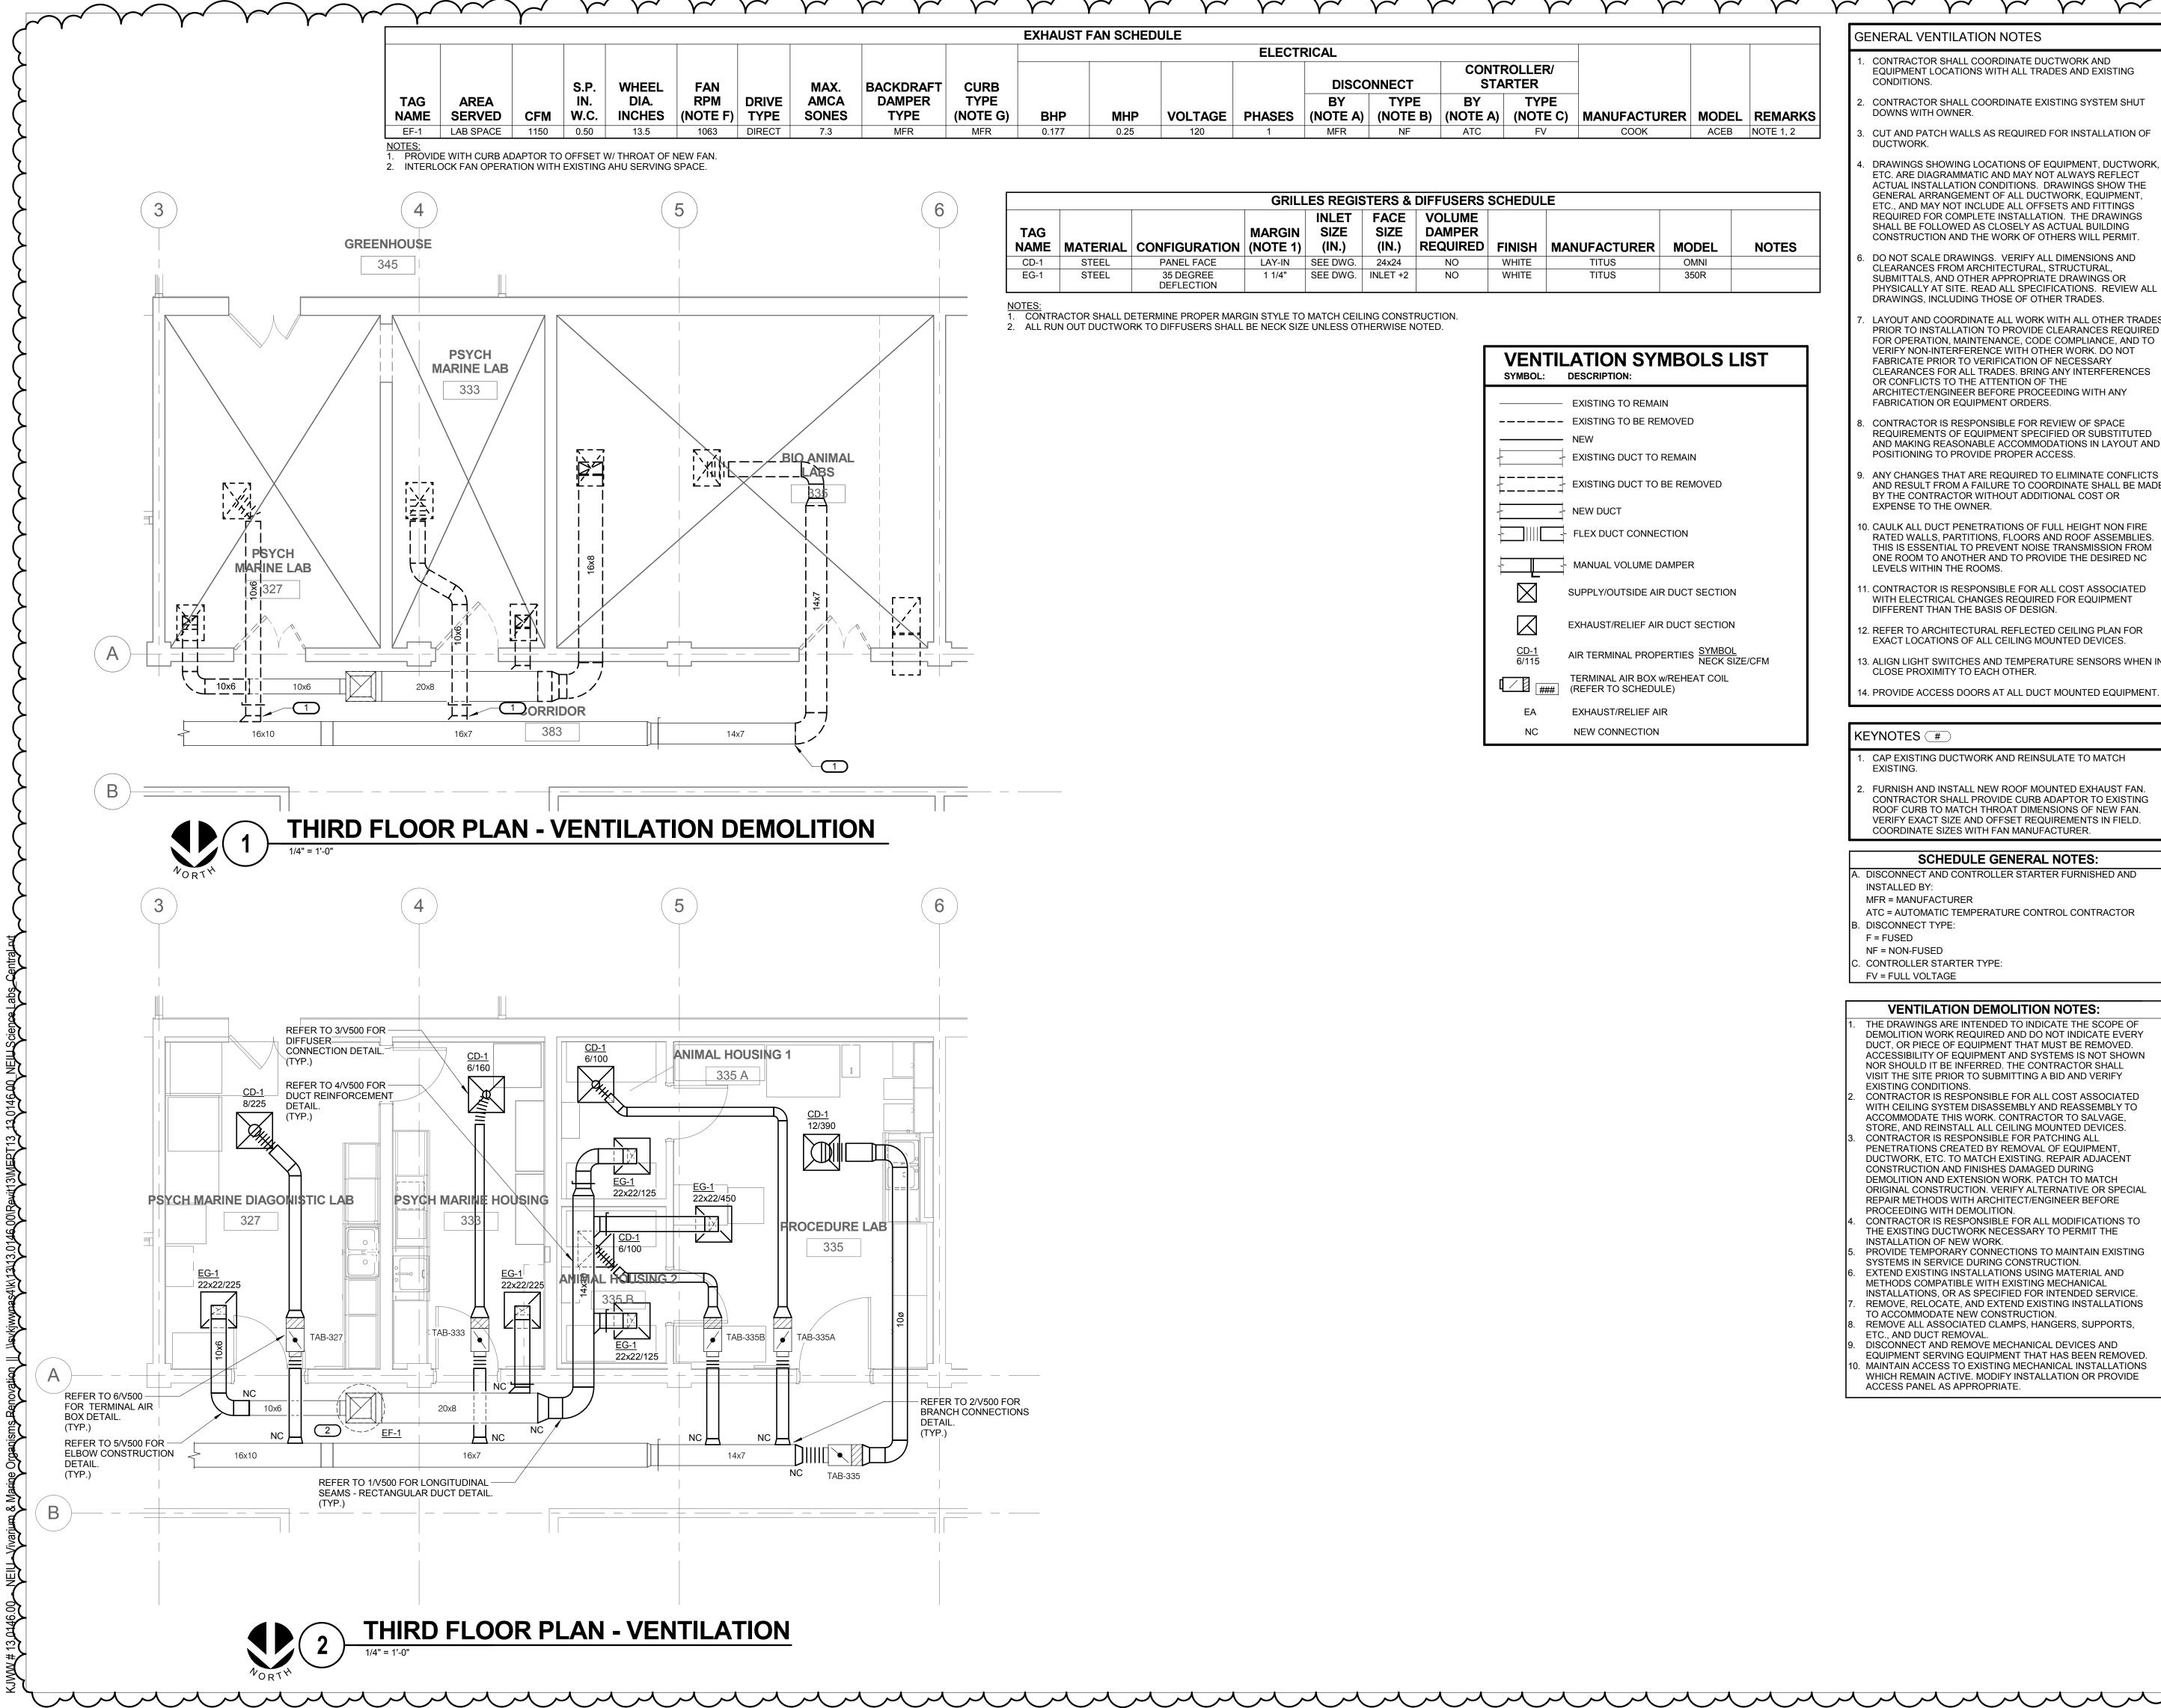


	Y Y	Y	Ŷ	Y Y	Y	Y	<u> </u>	Y Y	Y	Y	<u> </u>	Y
			EXHAUST I	FAN SCHED	JLE							
						ELECTI	RICAL					
MAX.	BACKDRAFT	AFT CURB CONTROLLER/										
AMCA SONES	DAMPER TYPE	TYPE (NOTE G)	BHP	MHP	VOLTAGE	PHASES	BY (NOTE A)	TYPE	BY (NOTE A)	TYPE (NOTE C)	MANUFACTURER	MOE
7.3	MFR	MFR	0.177	0.25	120	1	MFR	NF	ATC	FV	COOK	ACE

	GRILLES REGISTERS & DIFFUSERS SCHEDULE														
TAG NAME	MATERIAL	CONFIGURATION	MARGIN (NOTE 1)	INLET SIZE (IN.)	FACE SIZE (IN.)	VOLUME DAMPER REQUIRED	FINISH	MANUFACTURER	MODEL						
CD-1	STEEL	PANEL FACE	LAY-IN	SEE DWG.	24x24	NO	WHITE	TITUS	OMNI						
EG-1	STEEL	35 DEGREE DEFLECTION	1 1/4"	SEE DWG.	INLET +2	NO	WHITE	TITUS	350R						


CONTRACTOR SHALL DETERMINE PROPER MARGIN STYLE TO MATCH CEILING CONSTRUCTION. 2. ALL RUN OUT DUCTWORK TO DIFFUSERS SHALL BE NECK SIZE UNLESS OTHERWISE NOTED.


VENTIL SYMBOL:	ATION SYMBOLS
	EXISTING TO REMAIN
	EXISTING TO BE REMOVED
-	NEW - EXISTING DUCT TO REMAIN
	EXISTING DUCT TO BE REMOVE
-	- NEW DUCT
	- FLEX DUCT CONNECTION
	- MANUAL VOLUME DAMPER
\boxtimes	SUPPLY/OUTSIDE AIR DUCT SEC
\square	EXHAUST/RELIEF AIR DUCT SECT
<u>CD-1</u> 6/115	AIR TERMINAL PROPERTIES SYM
	TERMINAL AIR BOX w/REHEAT CO (REFER TO SCHEDULE)
EA	EXHAUST/RELIEF AIR
NC	NEW CONNECTION

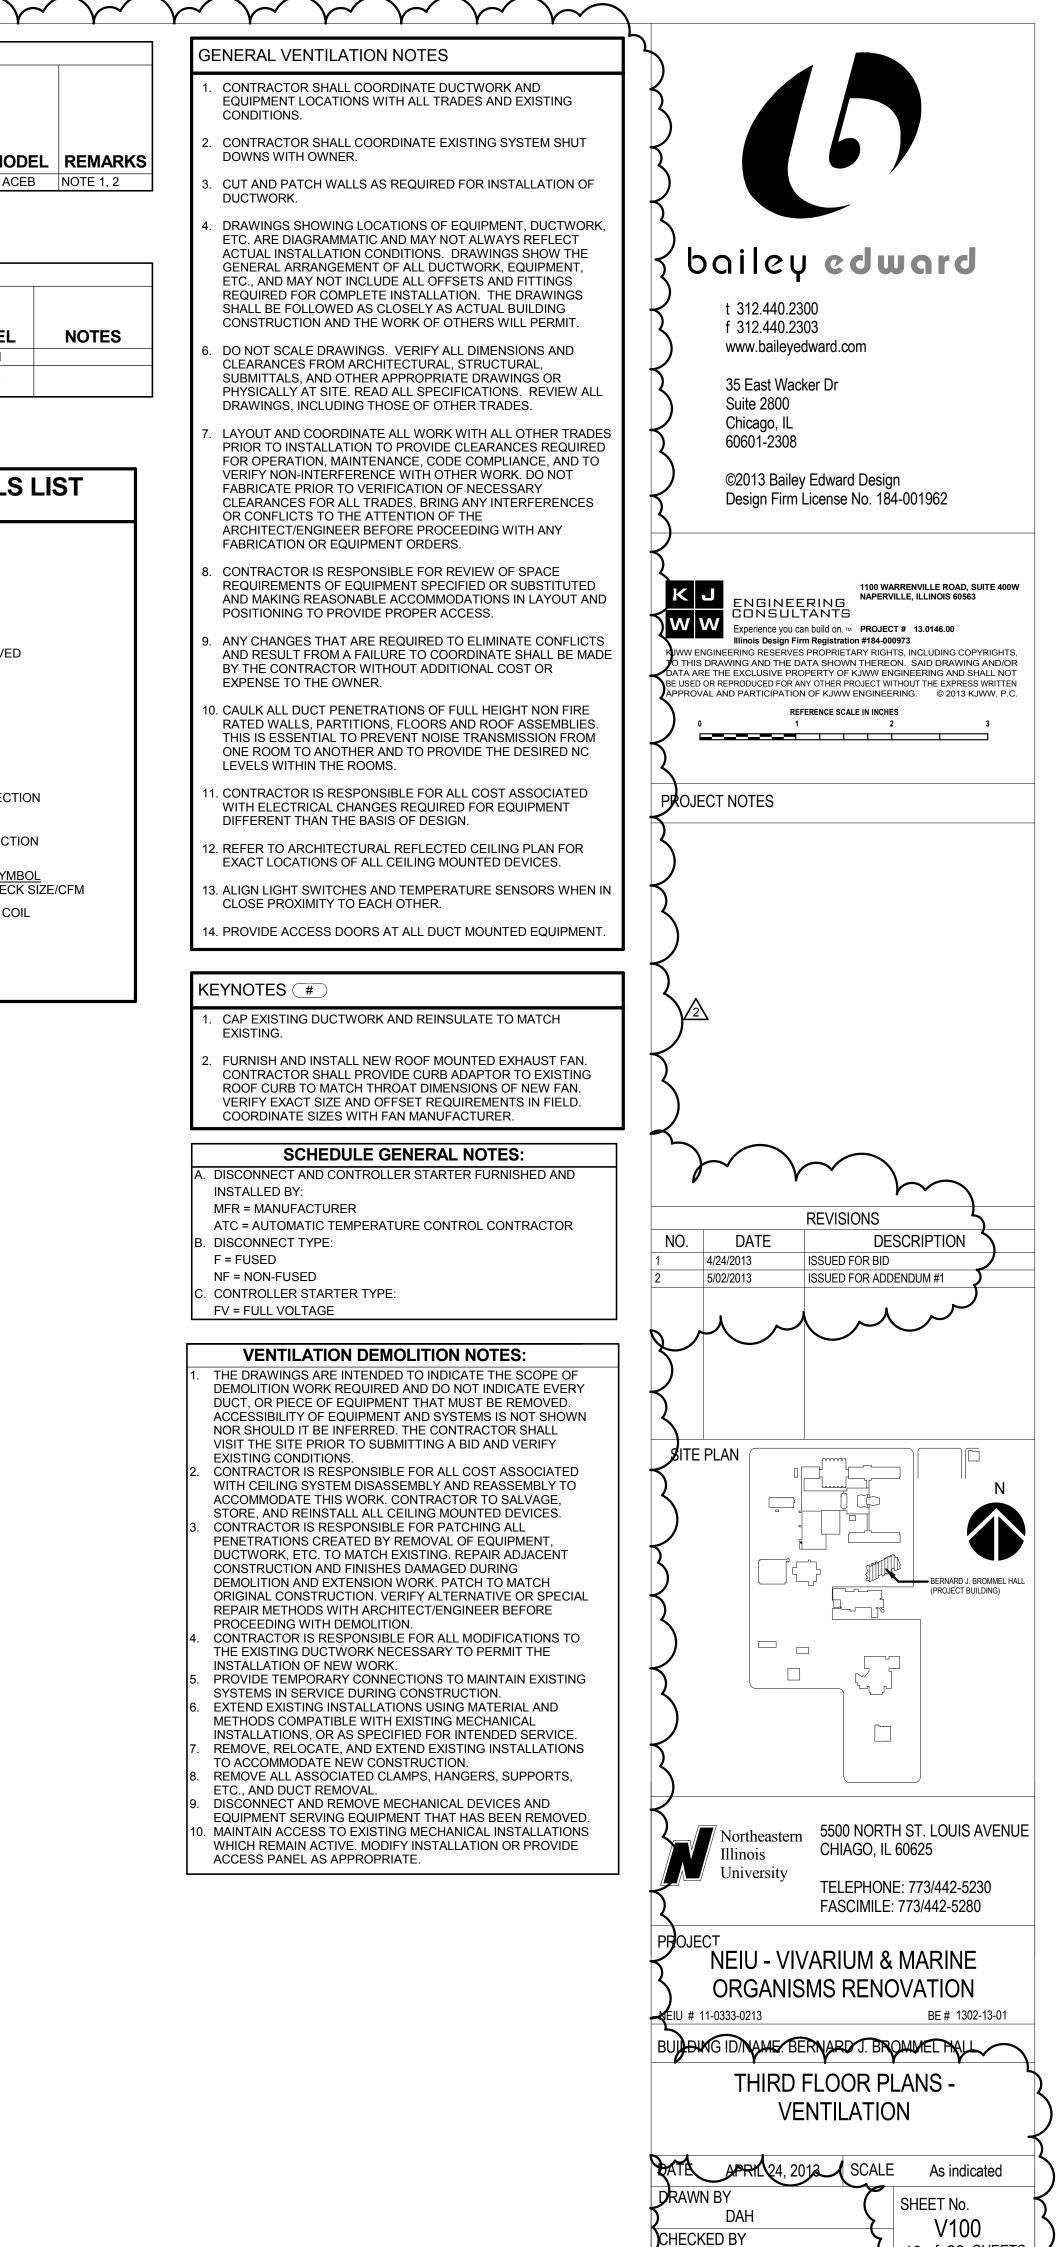


13 of 23 SHEETS

BMF

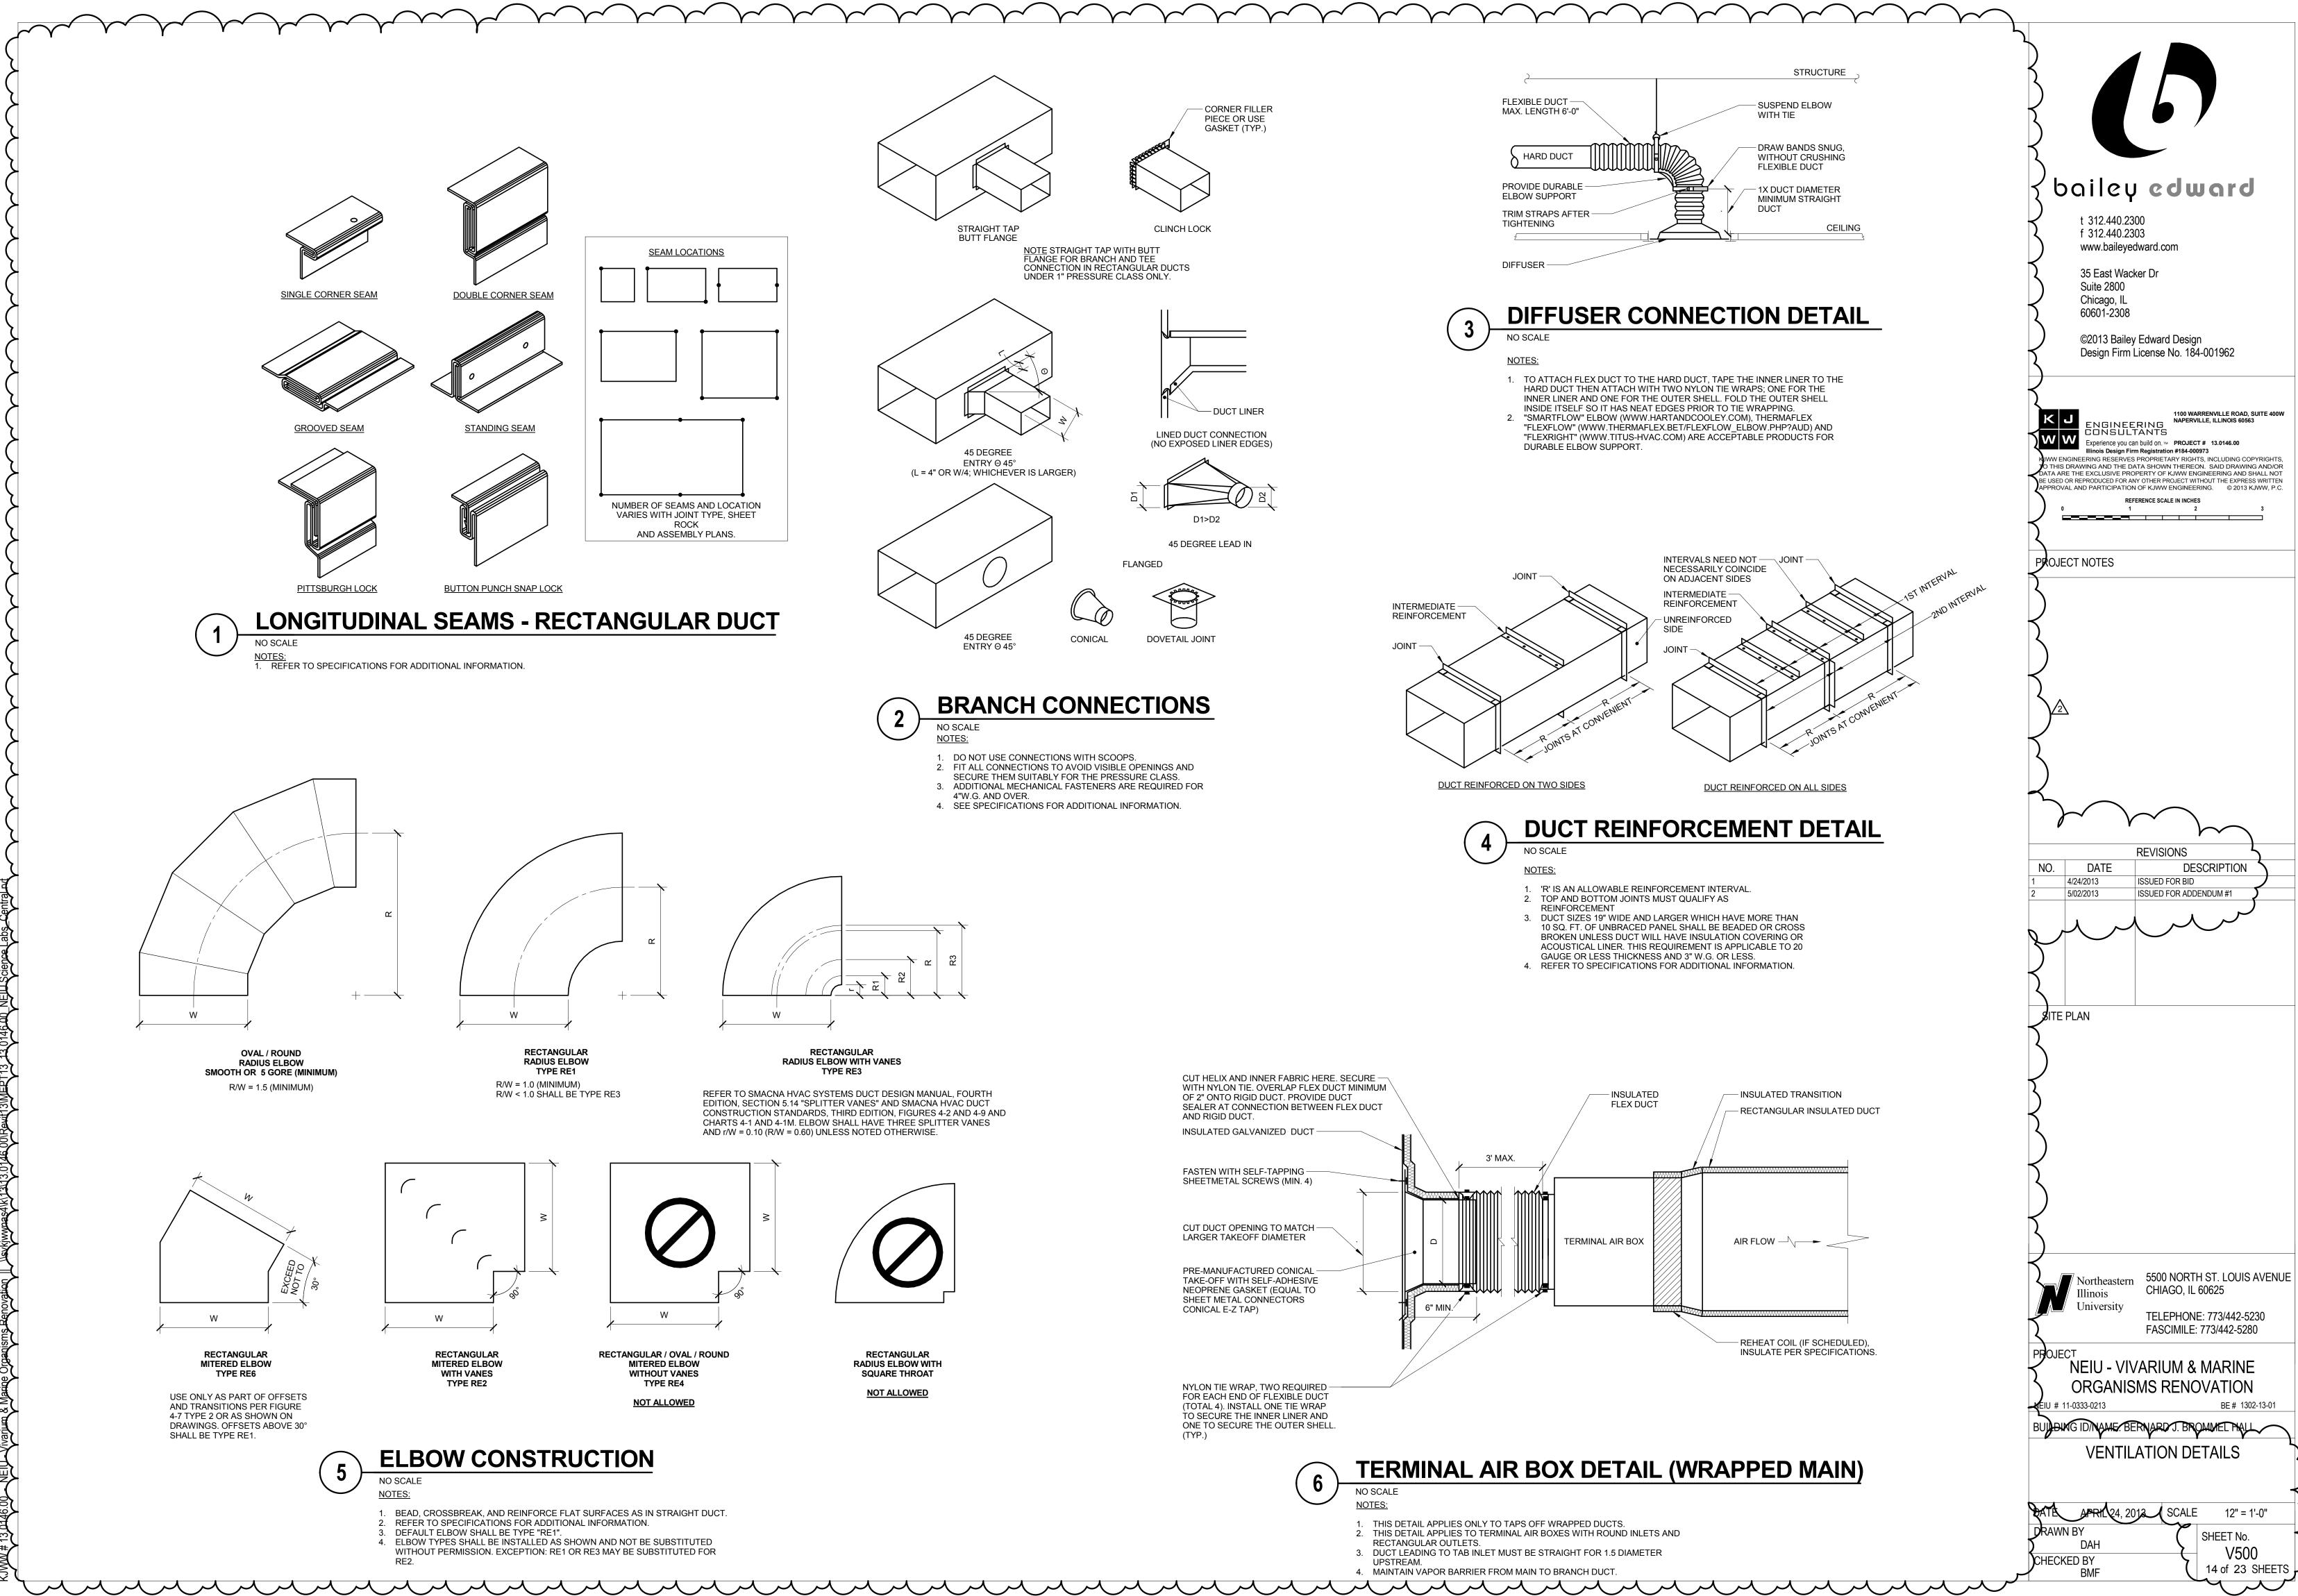

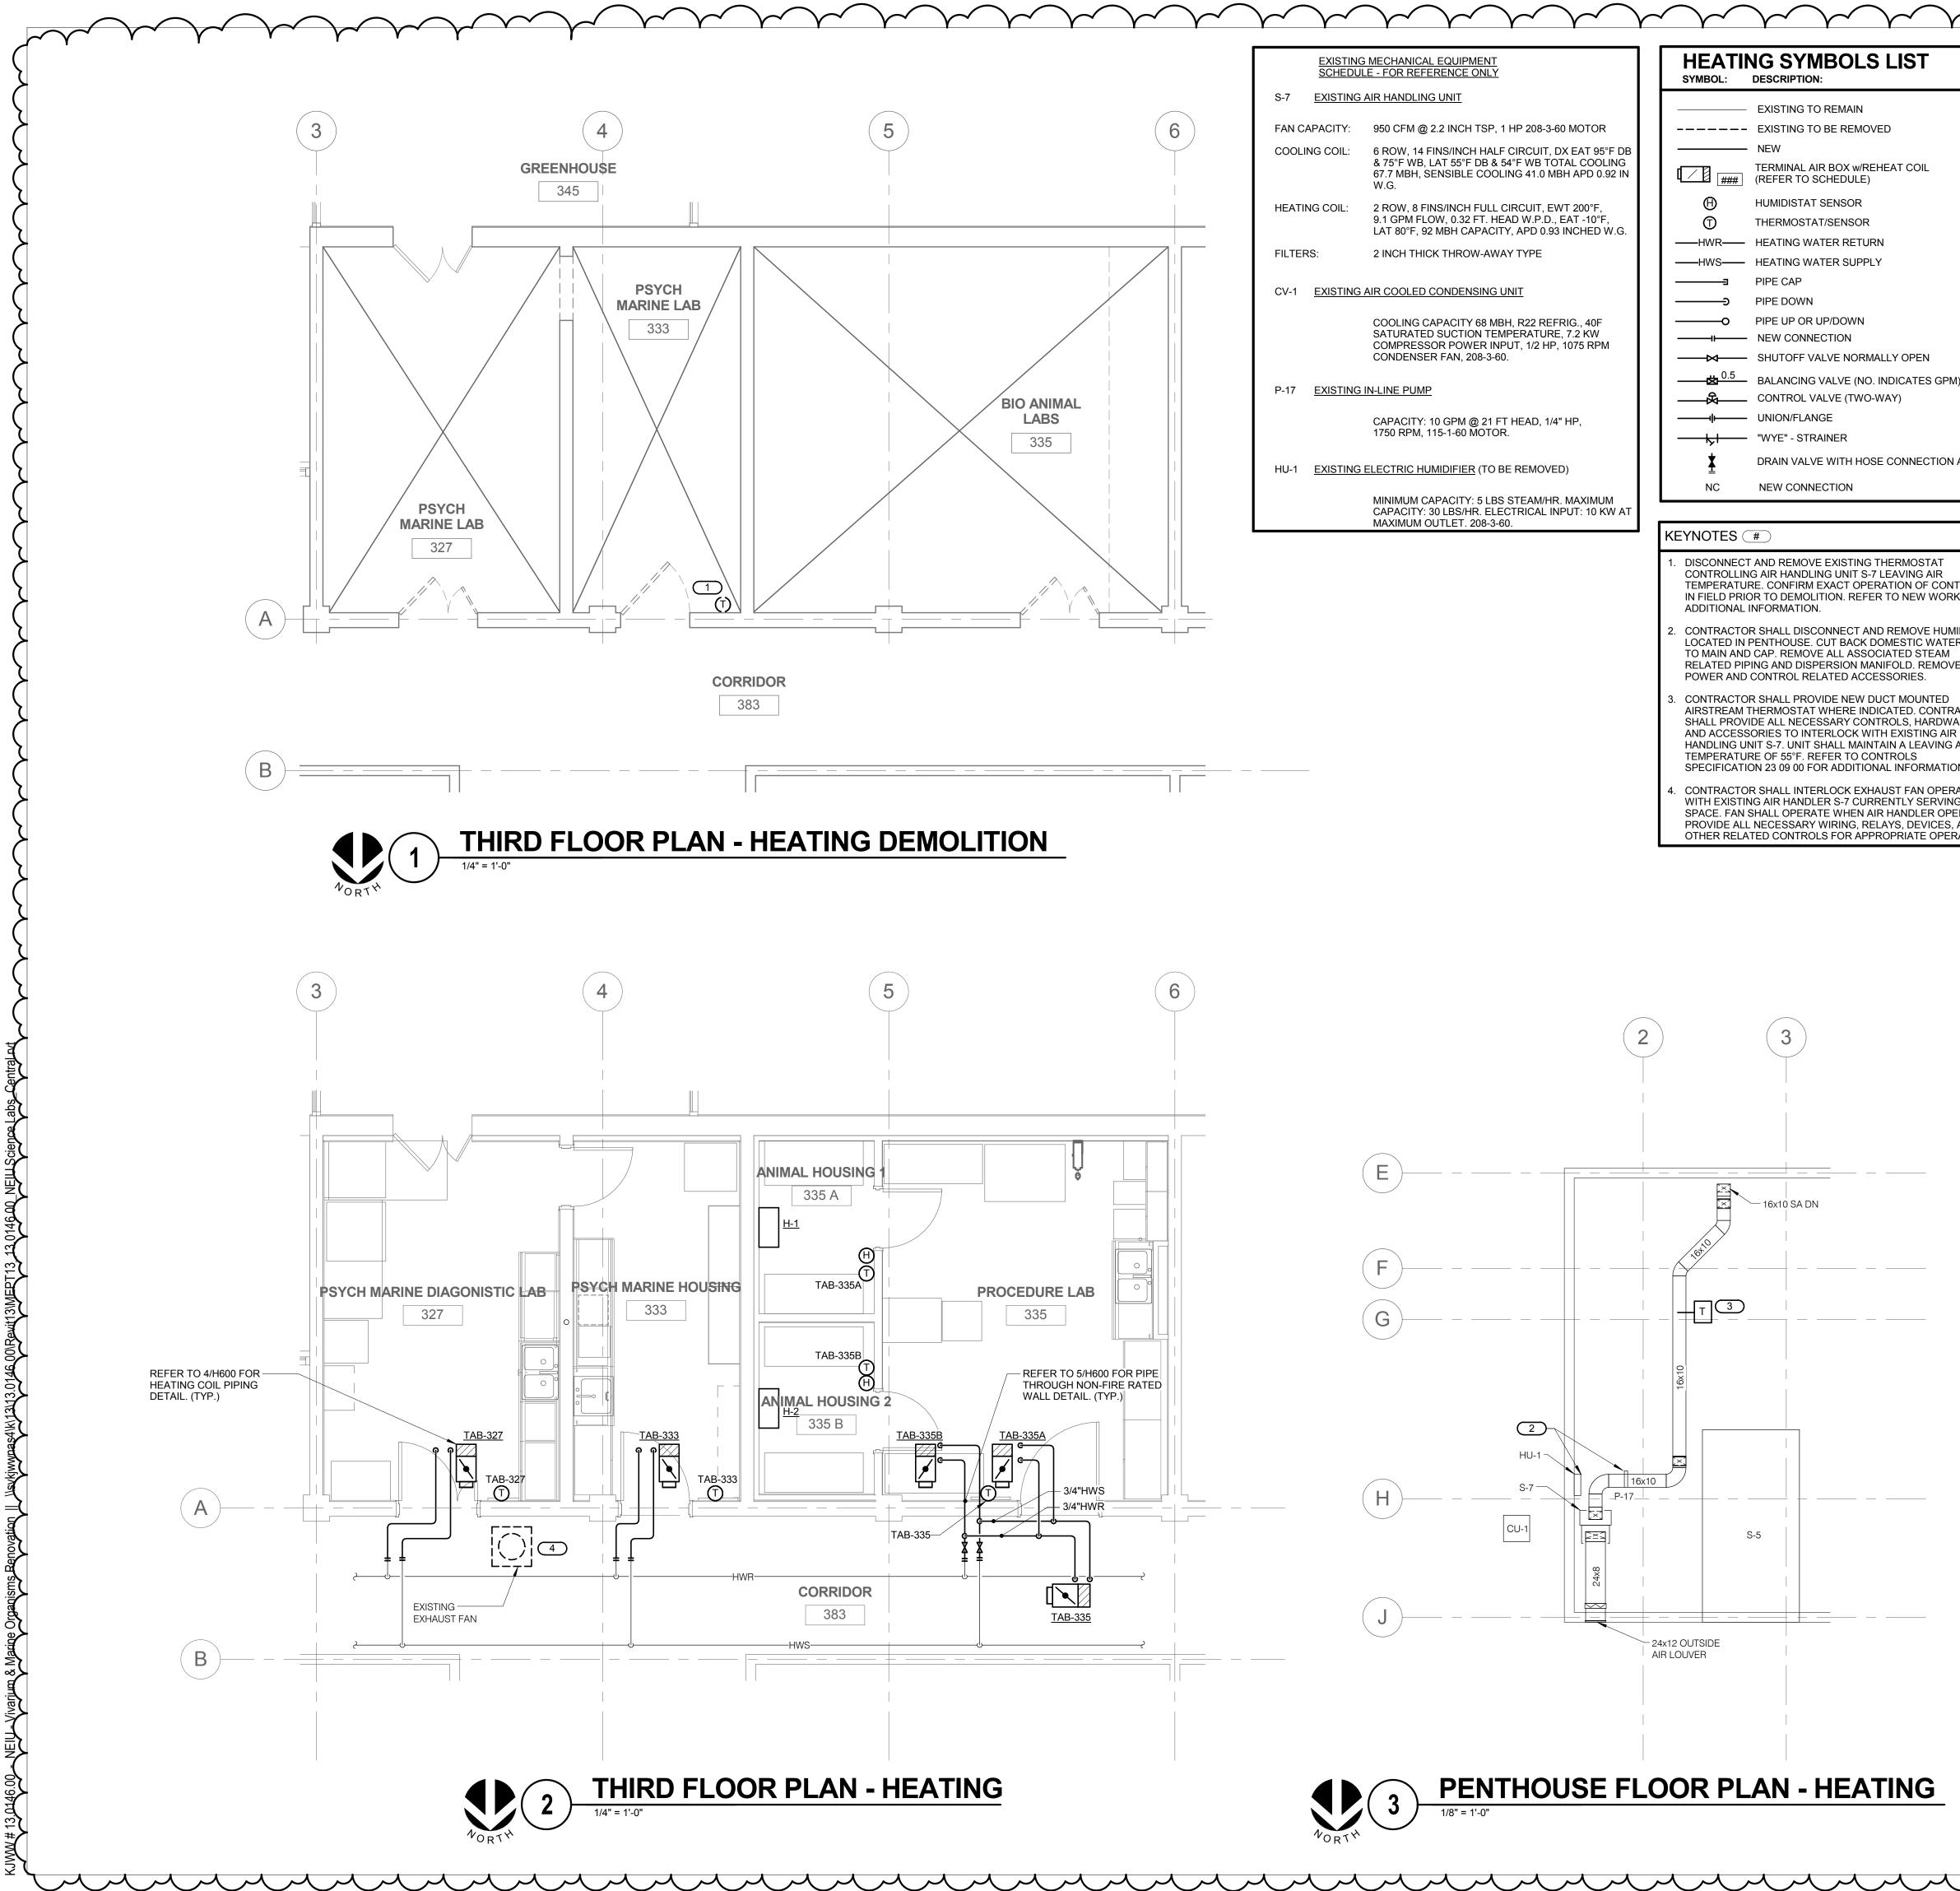

ST	GENERAL HEATING DEMOLITION NOTES
	1. FIELD VERIFY ALL EQUIPMENT PRIOR TO DEMOLITION. REPORT ANY DISCREPANCIES FOUND TO THE ARCHITECT OR ENGINEERING TEAM
	ENGINEERING TEAM.2. THE DRAWINGS ARE INTENDED TO INDICATE THE SCOPE OF DEMOLITION WORK REQUIRED AND DO NOT INDICATE EVERY
COIL	PIPE, OR PIECE OF EQUIPMENT THAT MUST BE REMOVED. ACCESSIBILITY OF EQUIPMENT AND SYSTEMS IS NOT SHOWN
	NOR SHOULD IT BE INFERRED. THE CONTRACTOR SHALL VISIT THE SITE PRIOR TO SUBMITTING A BID AND VERIFY EXISTING CONDITIONS.
	3. CONTRACTOR IS RESPONSIBLE FOR ALL COST ASSOCIATED WITH CEILING SYSTEM DISASSEMBLY AND REASSEMBLY TO
	ACCOMMODATE THIS WORK. CONTRACTOR TO SALVAGE, STORE, AND REINSTALL ALL CEILING MOUNTED DEVICES.
	 CONTRACTOR TO COORDINATE WITH OWNER FOR ALL MECHANICAL SERVICE OUTAGES. EXISTING WATER SYSTEM: MAINTAIN EXISTING SYSTEM IN SERVICE UNTIL NEW SYSTEM
	IS COMPLETE AND READY FOR SERVICE. DRAIN SYSTEM ONLY TO MAKE SWITCHOVERS AND CONNECTIONS. OBTAIN PERMISSION FROM OWNER AT LEAST 72 HOURS BEFORE
PEN	PARTIALLY OR COMPLETELY DRAINING SYSTEM. MINIMIZE OUTAGE DURING OPERATION.
ES GPM)	 CONTRACTOR IS RESPONSIBLE FOR PATCHING ALL PENETRATIONS CREATED BY REMOVAL OF EQUIPMENT, PIPING, ETC. TO MATCH EXISTING. REPAIR ADJACENT
	CONSTRUCTION AND FINISHES DAMAGED DURING DEMOLITION AND EXTENSION WORK. PATCH TO MATCH ORIGINAL CONSTRUCTION. VERIFY ALTERNATIVE OR SPECIAL
CTION AND CAP	REPAIR METHODS WITH ARCHITECT/ENGINEER BEFORE PROCEEDING WITH DEMOLITION.
	6. CONTRACTOR IS RESPONSIBLE FOR ALL MODIFICATIONS TO THE EXISTING HVAC PIPING NECESSARY TO PERMIT THE
	INSTALLATION OF NEW WORK. 7. PROVIDE TEMPORARY CONNECTIONS TO MAINTAIN EXISTING
STAT	SYSTEMS IN SERVICE DURING CONSTRUCTION. 8. EXTEND EXISTING INSTALLATIONS USING MATERIAL AND
AIR F CONTROLS / WORK FOR	METHODS COMPATIBLE WITH EXISTING MECHANICAL INSTALLATIONS, OR AS SPECIFIED FOR INTENDED SERVICE.
/E HUMIDIFIER	9. REMOVE, RELOCATE, AND EXTEND EXISTING INSTALLATIONS TO ACCOMMODATE NEW CONSTRUCTION.
WATER FEED EAM EMOVE ALL	10. REMOVE ALL ASSOCIATED CLAMPS, HANGERS, SUPPORTS, ETC., ASSOCIATED WITH PIPING REMOVAL.
	11. DISCONNECT AND REMOVE MECHANICAL DEVICES AND EQUIPMENT SERVING EQUIPMENT THAT HAS BEEN REMOVED.
ONTRACTOR ARDWARE	12. MAINTAIN ACCESS TO EXISTING MECHANICAL INSTALLATIONS WHICH REMAIN ACTIVE. MODIFY INSTALLATION OR PROVIDE
/ING AIR	ACCESS PANEL AS APPROPRIATE.
MATION. OPERATION	GENERAL HEATING NOTES
ERVING ER OPERATES. /ICES, AND	1. CONTRACTOR SHALL COORDINATE PIPING AND EQUIPMENT LOCATIONS WITH ALL TRADES AND EXISTING CONDITIONS.
OPERATION.	2. CONTRACTOR SHALL COORDINATE EXISTING SYSTEM SHUT DOWNS WITH OWNER.
	 CUT AND PATCH WALLS AS REQUIRED FOR INSTALLATION OF PIPING
	4. ALL HOT WATER SUPPLY AND HOT WATER RETURN PIPING TO
	BE MINIMUM 3/4" DIAMETER UNLESS INDICATED OTHERWISE.5. DRAWINGS SHOWING LOCATIONS OF EQUIPMENT, PIPING, ETC.
	ARE DIAGRAMMATIC AND MAY NOT ALWAYS REFLECT ACTUAL INSTALLATION CONDITIONS. DRAWINGS SHOW THE GENERAL ARRANGEMENT OF ALL PIPING, EQUIPMENT, ETC., AND MAY NOT
	INCLUDE ALL OFFSETS AND FITTINGS REQUIRED FOR COMPLETE INSTALLATION. THE DRAWINGS SHALL BE FOLLOWED AS CLOSELY AS ACTUAL BUILDING CONSTRUCTION
	AND THE WORK OF OTHERS WILL PERMIT.6. DO NOT SCALE DRAWINGS. VERIFY ALL DIMENSIONS AND
	CLEARANCES FROM ARCHITECTURAL, STRUCTURAL, SUBMITTALS, AND OTHER APPROPRIATE DRAWINGS OR PHYSICALLY AT SITE. READ ALL SPECIFICATIONS. REVIEW ALL
	DRAWINGS, INCLUDING THOSE OF OTHER TRADES.7. LAYOUT AND COORDINATE ALL WORK WITH ALL OTHER TRADES
	PRIOR TO INSTALLATION TO PROVIDE CLEARANCES REQUIRED FOR OPERATION, MAINTENANCE, CODE COMPLIANCE, AND TO VERIFY NON-INTERFERENCE WITH OTHER WORK. DO NOT
_	FABRICATE PRIOR TO VERIFICATION OF NECESSARY CLEARANCES FOR ALL TRADES. BRING ANY INTERFERENCES OR CONFLICTS TO THE ATTENTION OF THE
	ARCHITECT/ENGINEER BEFORE PROCEEDING WITH ANY FABRICATION OR EQUIPMENT ORDERS.
	8. CONTRACTOR IS RESPONSIBLE FOR REVIEW OF SPACE REQUIREMENTS OF EQUIPMENT SPECIFIED OR SUBSTITUTED AND MAKING REASONABLE ACCOMMODATIONS IN LAYOUT AND
_	POSITIONING TO PROVIDE PROPER ACCESS.
_	9. ANY CHANGES THAT ARE REQUIRED TO ELIMINATE CONFLICTS AND RESULT FROM A FAILURE TO COORDINATE SHALL BE MADE BY THE CONTRACTOR WITHOUT ADDITIONAL COST OR
	EXPENSE TO THE OWNER. 10. CAULK ALL PIPE PENETRATIONS OF FULL HEIGHT NON FIRE
	RATED WALLS, PARTITIONS, FLOORS AND ROOF ASSEMBLIES. THIS IS ESSENTIAL TO PREVENT NOISE TRANSMISSION FROM ONE ROOM TO ANOTHER AND TO PROVIDE THE DESIRED NC
	LEVELS WITHIN THE ROOMS. 11. CONTRACTOR IS RESPONSIBLE FOR ALL COST ASSOCIATED
	WITH ELECTRICAL CHANGES REQUIRED FOR EQUIPMENT DIFFERENT THAN THE BASIS OF DESIGN.
	12. TERMINAL AIR BOX (TAB) NUMBER OR REHEAT COIL NUMBER IS SHOWN ADJACENT TO THERMOSTAT ONLY WHEN THE TAB OR COIL WHICH THE THERMOSTAT IS CONTROLLING IS AMBIGUOUS.
	 13. ALIGN LIGHT SWITCHES AND TEMPERATURE SENSORS WHEN IN CLOSE PROXIMITY TO EACH OTHER.
-	
<u> </u>	
<u> </u>	

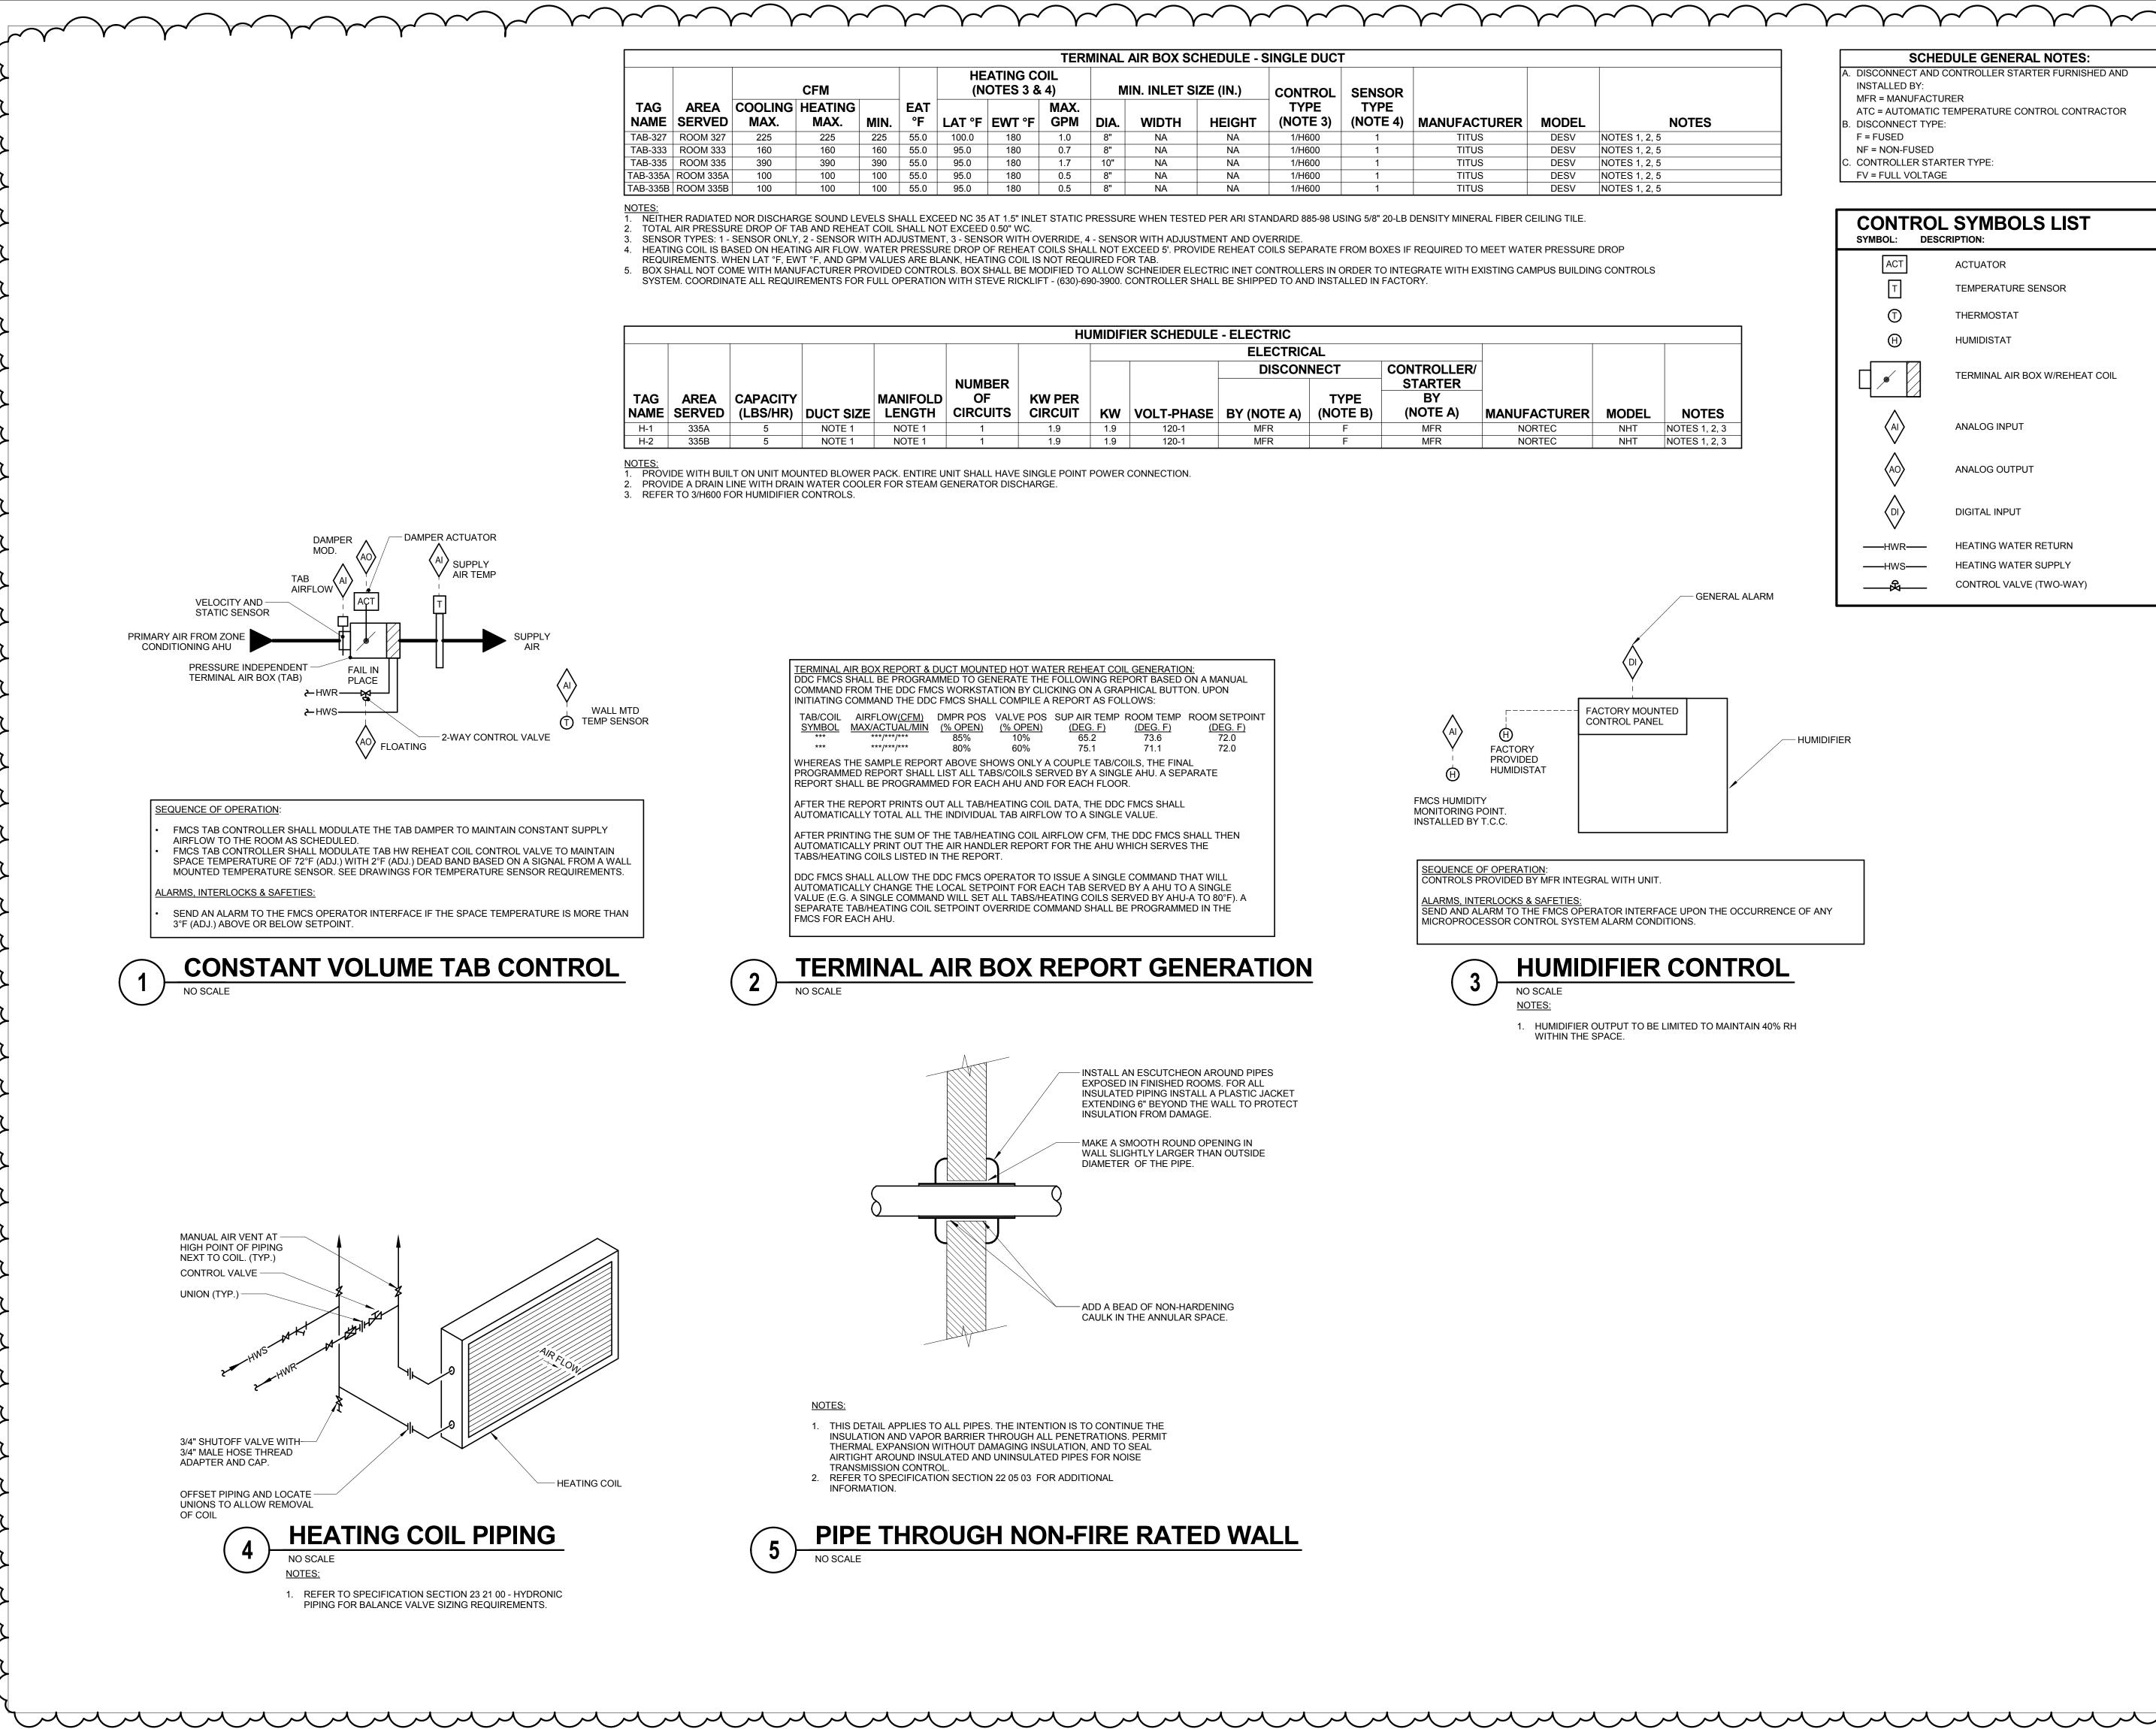

	TERMINAL AIR BOX SCHEDULE - SINGLE DUCT														
CFM			HEATING COIL (NOTES 3 & 4)		MIN. INLET SIZE (IN.)			CONTROL	SENSOR						
HEATING MAX.	MIN.	EAT °E		EWT °F	MAX. GPM	DIA.	WIDTH	HEIGHT	TYPE (NOTE 3)	TYPE (NOTE 4)	MANUFACTURER	MODEL	NOTES		
	IVIIIN.	Г			GFIW	DIA.		псібні			WANUFACIURER	INIODEL	NOTE3		
225	225	55.0	100.0	180	1.0	8"	NA	NA	1/H600	1	TITUS	DESV	NOTES 1, 2, 5		
160	160	55.0	95.0	180	0.7	8"	NA	NA	1/H600	1	TITUS	DESV	NOTES 1, 2, 5		
390	390	55.0	95.0	180	1.7	10"	NA	NA	1/H600	1	TITUS	DESV	NOTES 1, 2, 5		
100	100	55.0	95.0	180	0.5	8"	NA	NA	1/H600	1	TITUS	DESV	NOTES 1, 2, 5		
100	100	55.0	95.0	180	0.5	8"	NA	NA	1/H600	1	TITUS	DESV	NOTES 1, 2, 5		

. NEITHER RADIATED NOR DISCHARGE SOUND LEVELS SHALL EXCEED NC 35 AT 1.5" INLET STATIC PRESSURE WHEN TESTED PER ARI STANDARD 885-98 USING 5/8" 20-LB DENSITY MINERAL FIBER CEILING TILE.

3. SENSOR TYPES: 1 - SENSOR ONLY, 2 - SENSOR WITH ADJUSTMENT, 3 - SENSOR WITH OVERRIDE, 4 - SENSOR WITH ADJUSTMENT AND OVERRIDE.

4. HEATING COIL IS BASED ON HEATING AIR FLOW. WATER PRESSURE DROP OF REHEAT COILS SHALL NOT EXCEED 5'. PROVIDE REHEAT COILS SEPARATE FROM BOXES IF REQUIRED TO MEET WATER PRESSURE DROP REQUIREMENTS. WHEN LAT °F, EWT °F, AND GPM VALUES ARE BLANK, HEATING COIL IS NOT REQUIRED FOR TAB.

5. BOX SHALL NOT COME WITH MANUFACTURER PROVIDED CONTROLS. BOX SHALL BE MODIFIED TO ALLOW SCHNEIDER ELECTRIC INET CONTROLLERS IN ORDER TO INTEGRATE WITH EXISTING CAMPUS BUILDING CONTROLS SYSTEM. COORDINATE ALL REQUIREMENTS FOR FULL OPERATION WITH STEVE RICKLIFT - (630)-690-3900. CONTROLLER SHALL BE SHIPPED TO AND INSTALLED IN FACTORY.

HUMIDIFIER SCHEDULE - ELECTRIC											
				ELECTRICAL							
						DISCON	NECT	CONTROLLER/			
		NUMBER						STARTER			
,	MANIFOLD		KW PER				TYPE	BY			
DUCT SIZE	LENGTH	CIRCUITS	CIRCUIT	KW	VOLT-PHASE	BY (NOTE A)	(NOTE B)	(NOTE A)	MANUFACTURER	MODEL	NOTE
NOTE 1	NOTE 1	1	1.9	1.9	120-1	MFR	F	MFR	NORTEC	NHT	NOTES 1, 2
NOTE 1	NOTE 1	1	1.9	1.9	120-1	MFR	F	MFR	NORTEC	NHT	NOTES 1, 2

1. PROVIDE WITH BUILT ON UNIT MOUNTED BLOWER PACK. ENTIRE UNIT SHALL HAVE SINGLE POINT POWER CONNECTION. 2. PROVIDE A DRAIN LINE WITH DRAIN WATER COOLER FOR STEAM GENERATOR DISCHARGE.


> ERMINAL AIR BOX REPORT & DUCT MOUNTED HOT WATER REHEAT COIL GENERATION: DDC FMCS SHALL BE PROGRAMMED TO GENERATE THE FOLLOWING REPORT BASED ON A MANUAL COMMAND FROM THE DDC FMCS WORKSTATION BY CLICKING ON A GRAPHICAL BUTTON. UPON INITIATING COMMAND THE DDC FMCS SHALL COMPILE A REPORT AS FOLLOWS: TAB/COIL AIRFLOW(CFM) DMPR POS VALVE POS SUP AIR TEMP ROOM TEMP ROOM SETPOINT
> SYMBOL
> MAX/ACTUAL/MIN
> (% OPEN)
> (% OPEN)
> (DEG. F)
> (DEG. F)
>
>
> ****
> ***/***
> 85%
> 10%
> 65.2
> 73.6
> <u>(DEG. F)</u> *** ***/***/*** 80% 60% 75.1 71.1 72.0 WHEREAS THE SAMPLE REPORT ABOVE SHOWS ONLY A COUPLE TAB/COILS, THE FINAL PROGRAMMED REPORT SHALL LIST ALL TABS/COILS SERVED BY A SINGLE AHU. A SEPARATE REPORT SHALL BE PROGRAMMED FOR EACH AHU AND FOR EACH FLOOR. AFTER THE REPORT PRINTS OUT ALL TAB/HEATING COIL DATA, THE DDC FMCS SHALL AUTOMATICALLY TOTAL ALL THE INDIVIDUAL TAB AIRFLOW TO A SINGLE VALUE.

AFTER PRINTING THE SUM OF THE TAB/HEATING COIL AIRFLOW CFM, THE DDC FMCS SHALL THEN AUTOMATICALLY PRINT OUT THE AIR HANDLER REPORT FOR THE AHU WHICH SERVES THE TABS/HEATING COILS LISTED IN THE REPORT.

DDC FMCS SHALL ALLOW THE DDC FMCS OPERATOR TO ISSUE A SINGLE COMMAND THAT WILL AUTOMATICALLY CHANGE THE LOCAL SETPOINT FOR EACH TAB SERVED BY A AHU TO A SINGLE VALUE (E.G. A SINGLE COMMAND WILL SET ALL TABS/HEATING COILS SERVED BY AHU-A TO 80°F). A SEPARATE TAB/HEATING COIL SETPOINT OVERRIDE COMMAND SHALL BE PROGRAMMED IN THE FMCS FOR EACH AHU.

TERMINAL AIR BOX REPORT GENERATION

NO SCALE

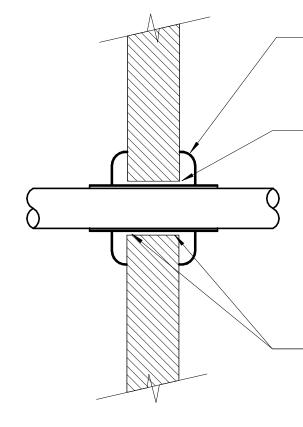

- INSTALL AN ESCUTCHEON AROUND PIPES EXPOSED IN FINISHED ROOMS. FOR ALL INSULATED PIPING INSTALL A PLASTIC JACKET EXTENDING 6" BEYOND THE WALL TO PROTECT INSULATION FROM DAMAGE.

- MAKE A SMOOTH ROUND OPENING IN WALL SLIGHTLY LARGER THAN OUTSIDE DIAMETER OF THE PIPE.

- ADD A BEAD OF NON-HARDENING CAULK IN THE ANNULAR SPACE.

NOTES:

- 1. THIS DETAIL APPLIES TO ALL PIPES. THE INTENTION IS TO CONTINUE THE INSULATION AND VAPOR BARRIER THROUGH ALL PENETRATIONS. PERMIT THERMAL EXPANSION WITHOUT DAMAGING INSULATION, AND TO SEAL AIRTIGHT AROUND INSULATED AND UNINSULATED PIPES FOR NOISE
- TRANSMISSION CONTROL.
- REFER TO SPECIFICATION SECTION 22 05 03 FOR ADDITIONAL INFORMATION.

PIPE THROUGH NON-FIRE RATED WALL

NO SCALE

FACTORY MOUNTED CONTROL PANEL (H)FACTORY PROVIDED HUMIDISTAT (H) FMCS HUMIDITY MONITORING POINT INSTALLED BY T.C.C.

SEQUENCE OF OPERATION: CONTROLS PROVIDED BY MFR INTEGRAL WITH UNIT.

NO SCALE

3


ALARMS, INTERLOCKS & SAFETIES:


SEND AND ALARM TO THE FMCS OPERATOR INTERFACE UPON THE OCCURRENCE OF ANY MICROPROCESSOR CONTROL SYSTEM ALARM CONDITIONS.


HUMIDIFIER CONTROL


NOTES:


1. HUMIDIFIER OUTPUT TO BE LIMITED TO MAINTAIN 40% RH WITHIN THE SPACE.

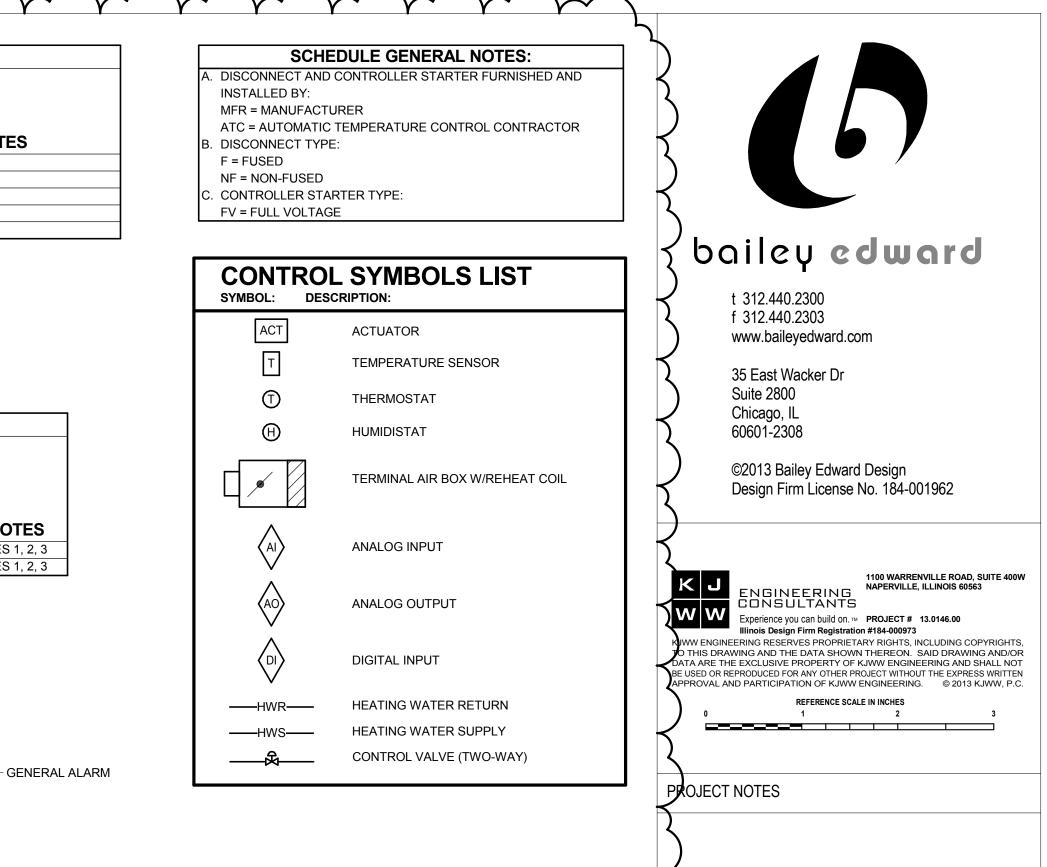

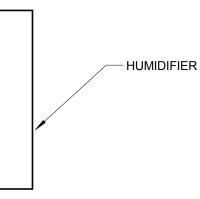

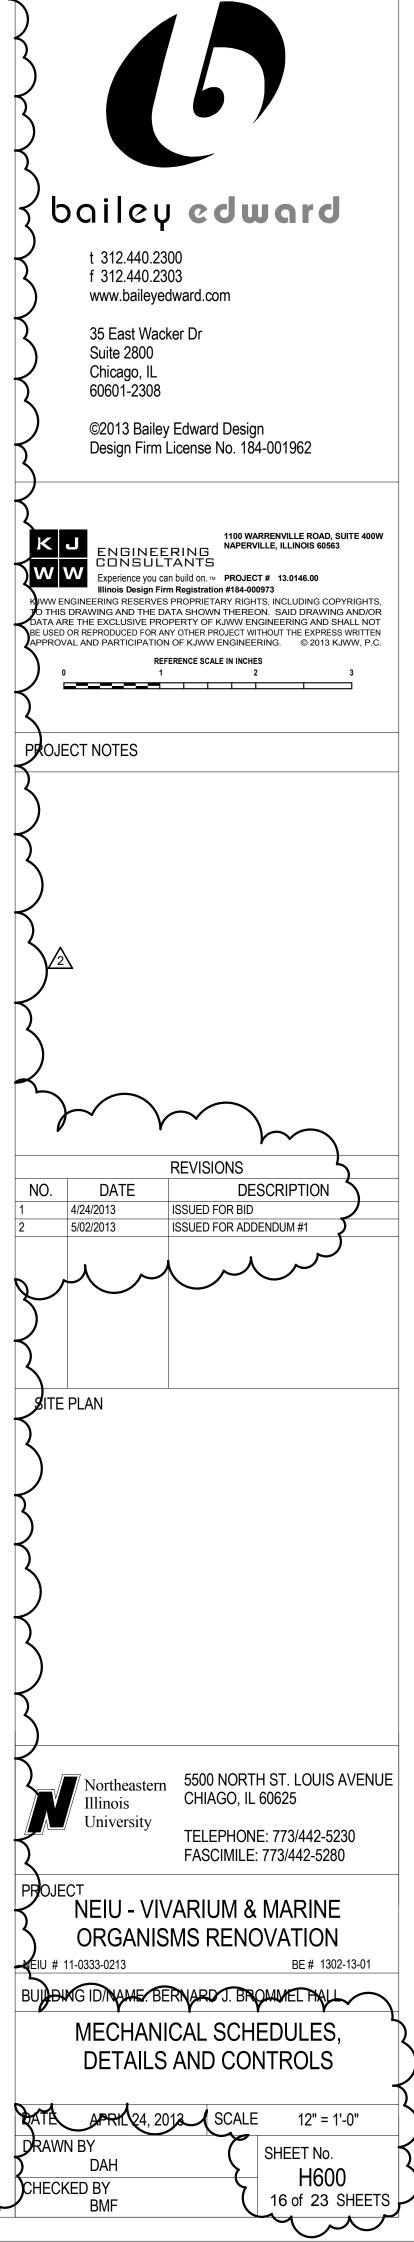

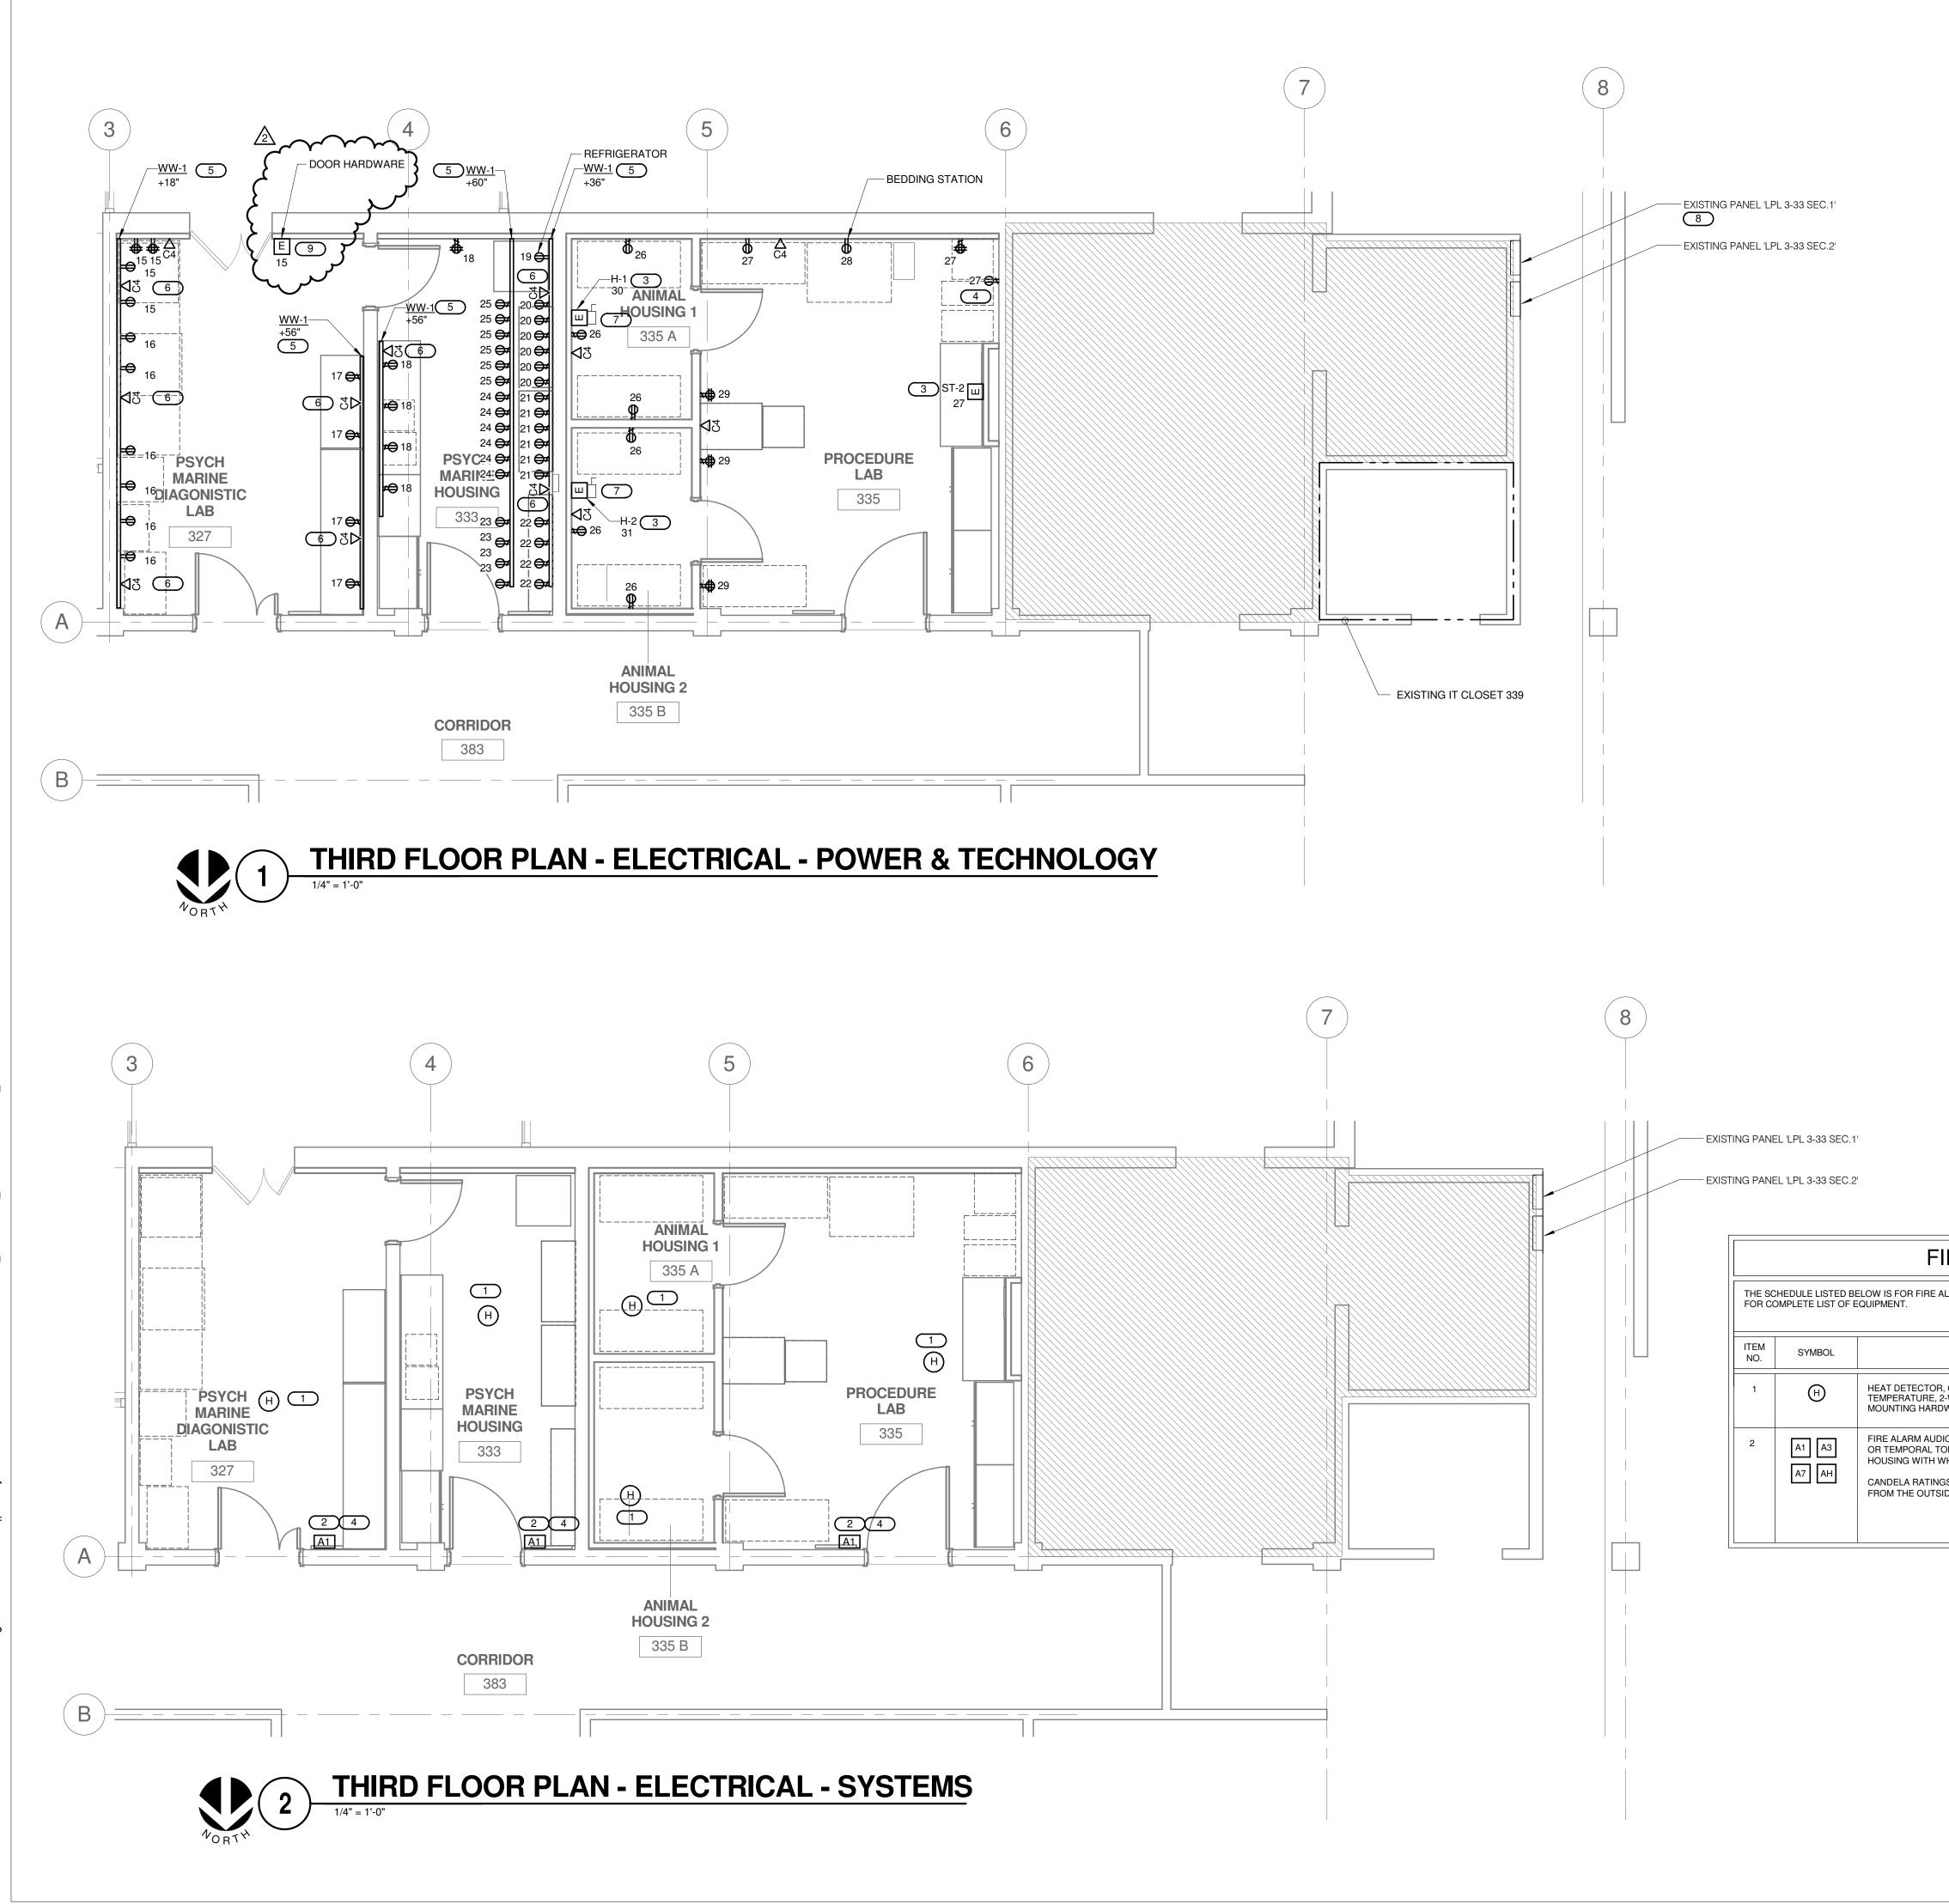

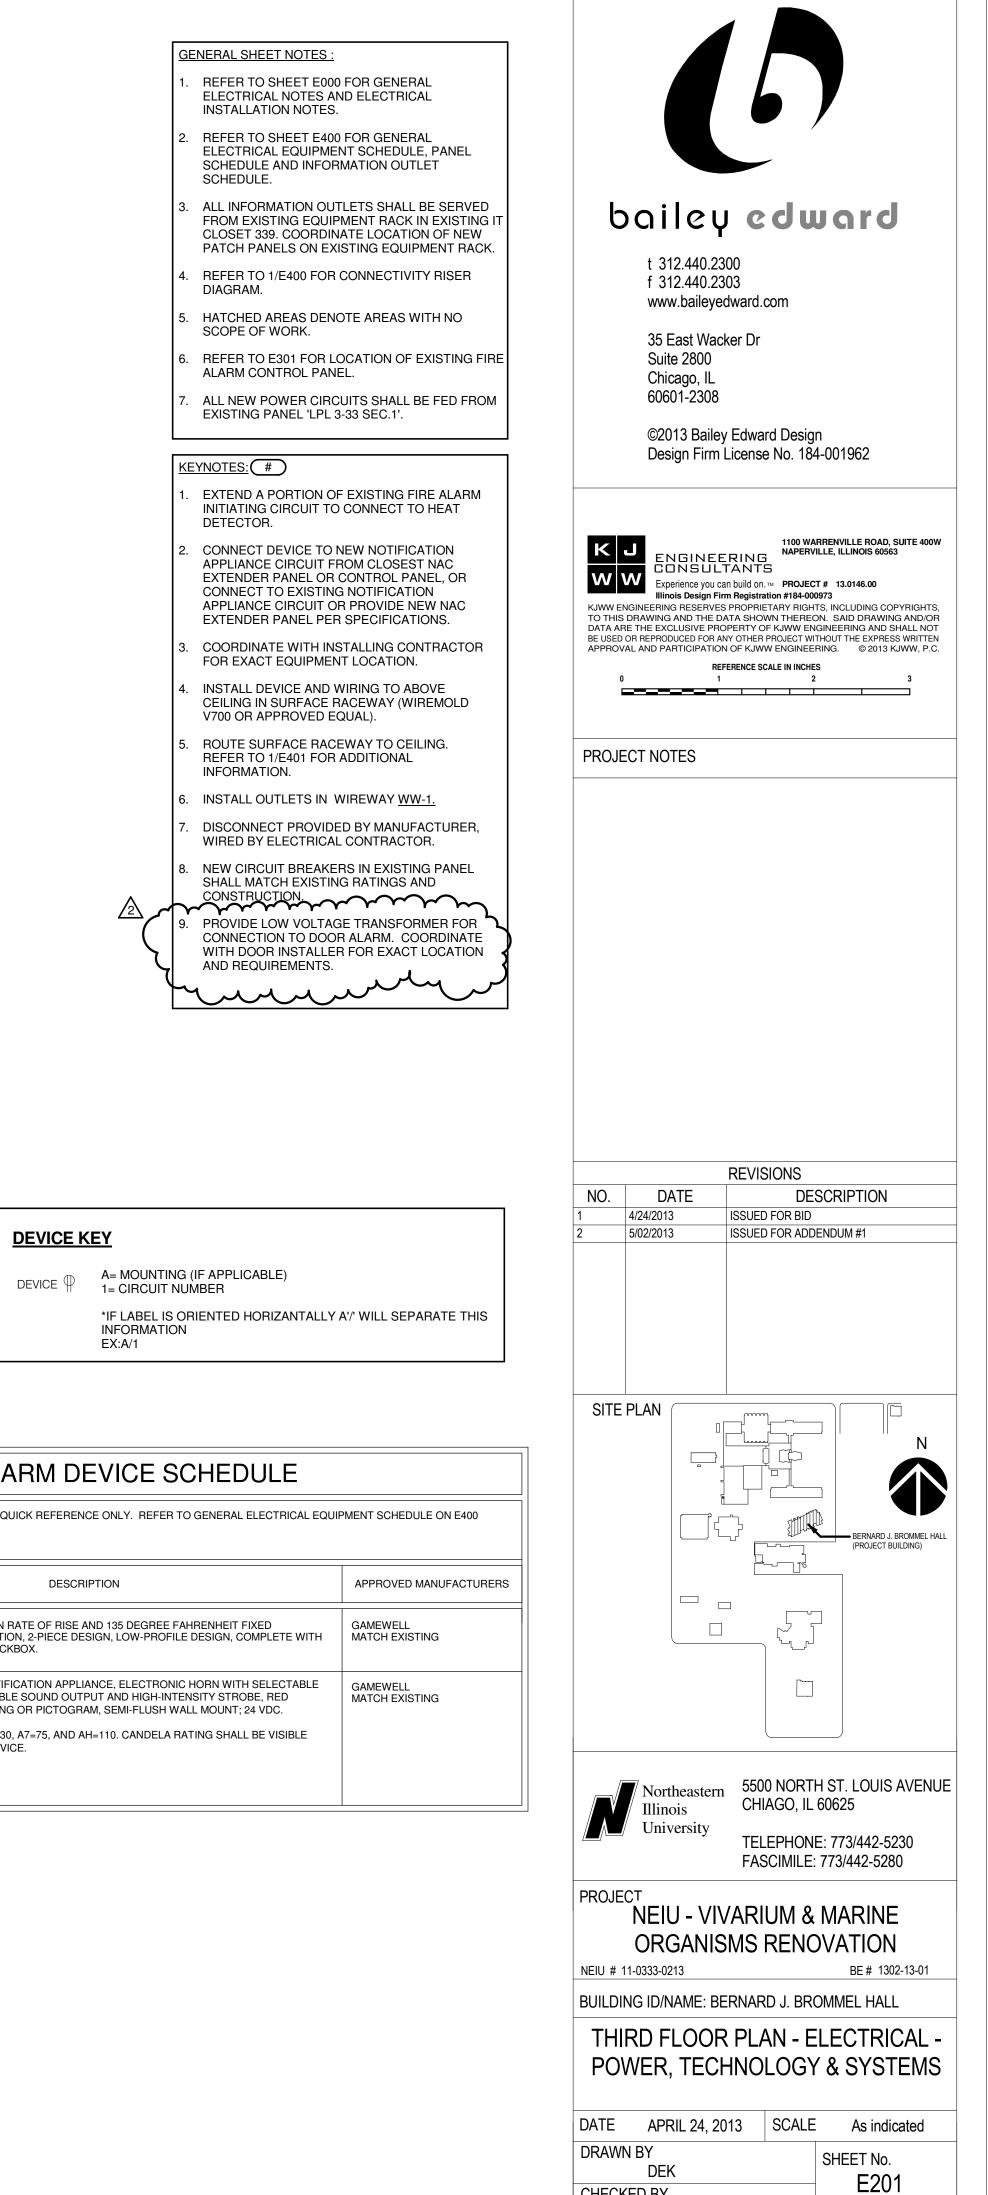

CHECKED BY

JMI

20 of 23 SHEETS

device \P	A= MOUNTING (IF APPLICABLE) 1= CIRCUIT NUMBER
	*IF LABEL IS ORIENTED HORIZANTALLY A'/' WILL SEPARA INFORMATION EX:A/1

FIRE ALARM DEVICE SCHEDULE

THE SCHEDULE LISTED BELOW IS FOR FIRE ALARM DEVICE QUICK REFERENCE ONLY. REFER TO GENERAL ELECTRICAL EQUIPMENT SCHEDULE ON E400

DESCRIPTION	APPROVED MANUFACT
, COMBINATION RATE OF RISE AND 135 DEGREE FAHRENHEIT FIXED 2-WIRE OPERATION, 2-PIECE DESIGN, LOW-PROFILE DESIGN, COMPLETE WITH WARE AND BACKBOX.	GAMEWELL MATCH EXISTING
IO/VISUAL NOTIFICATION APPLIANCE, ELECTRONIC HORN WITH SELECTABLE DNE, SELECTABLE SOUND OUTPUT AND HIGH-INTENSITY STROBE, RED /HITE LETTERING OR PICTOGRAM, SEMI-FLUSH WALL MOUNT; 24 VDC.	GAMEWELL MATCH EXISTING
GS: A1=15, A3=30, A7=75, AND AH=110. CANDELA RATING SHALL BE VISIBLE DE OF THE DEVICE.	